


Section 20
Section 29

1/4 Cor Secs. 20-29, T24S, R3W.
Fd Iron Post with brass cap
set by G.L.O.

N 0°26'30"W, 2544.0 (This survey) =
North, 2706.0 (Roberts survey)

RF
Arthur R. Evans

Fd. Alder B.T. set as
witness for mid-point on
N. & S. of Section 29 cor. bears
N79°E, 781Ks. Renew cor. by
setting 1 1/2" Iron Post. New B.T.s
14" Cedar, S65°E, 33.5 ft.
14" Cedar, N53°E, 28.6 ft.

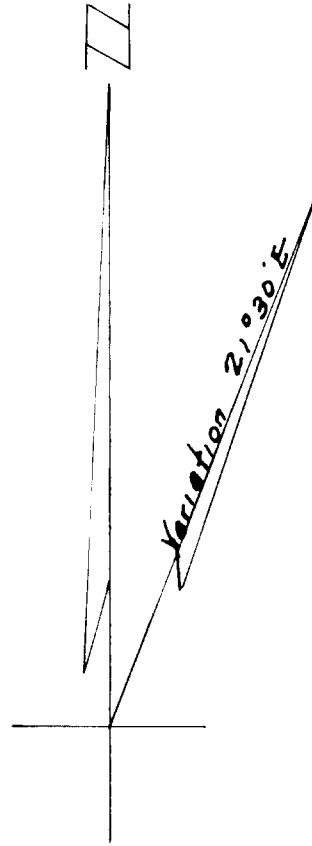

J. V. Chenoweth.

Vol. 184 P. 291
Deed Records, Doug. Co.

Calapooia Creek

SURVEY TO RE-ESTABLISH
MID-POINT ON
NORTH & SOUTH CENTER-
LINE, SEC. 29, T24S, R3W,
AS ORIGINALLY SET BY
C.E. ROBERTS, CO. SURVEYOR

CORNER RE-ESTABLISHED
BY A.R. EVANS, REG. CIVIL ENGR.
APRIL 1952
SCALE 1" = 500'

COUNTY SURVEYORS FILE DATA
DO NOT REMOVE FROM OFFICE