

2-7-53

Sec. Cor. 13-24, Range Line
T30S, R6W, W.M.

as determined by O.B.T.

A B.O. stump bears N65W
400' dist. O.B.T.

A W.O. 25" diam. bears S60W,
69.0' dist. O.B.T.


At corner point set $\frac{1}{2}$ " x 20" I.P.
from which

A W.O. 30" diam. bears S76W,
89.5' dist. mid. S24, T30S, R6W, B.T.

A L.A. 9" diam. bears N67W, 21.0'
dist. mid. S13, B.T.

Fences running N-S-W from cor.
Fence cor. bears North 7' dist.

Witness: Jim Loper

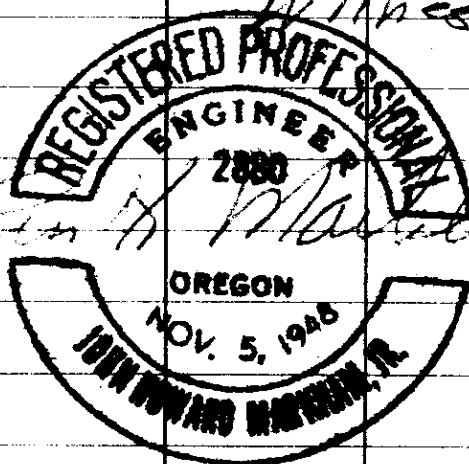

Work done for Riddle Mfg. Co.

41/113-1