

2-9-53

East  $\frac{1}{4}$  corner Section 24

T30S, R6W, W.N. as determined by O.B.T.

A B.O. stump bears S36W, 26'

A B.O. windfall 26" diam. bears S57E, 20.0' dist. fd. scribe

At corner point found

2 large stones and 4"x4" wood post. I set 1"x30" IP. from which

A 1a, 8" diam. bears S59W 52.5' dist. mkd.  $\frac{1}{4}$ S 24 B.T.


A B.O. 16" diam. bears N79W 55.0' dist. mkd.  $\frac{1}{4}$ S 24

T30S, R6W B.T.

A 1a, 10" diam. bears S28E 4.3' dist. mkd.  $\frac{1}{4}$ S 24, B.T.

West  $\frac{1}{4}$  cor. Sec. 19, T30S, R5W bears South 115.0' dist.

Fence bears N37°E 153.0' and runs W+N.

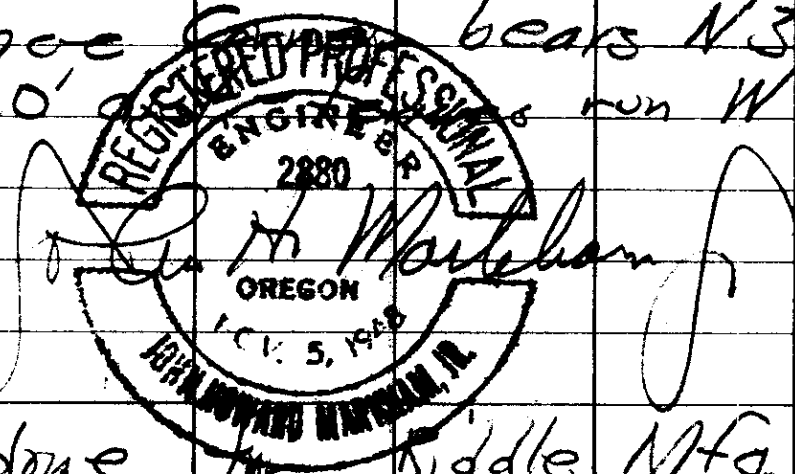

Work done for Kiddle Mfg. Co. 41713-2