


Re-establishment of
Govt. corner.

$$\begin{array}{r} 31 \overline{) 32} \\ \underline{6} \\ 65 \end{array}$$
 T 225, R 5W
T 235, R 5W

Fd. Rock with X
apparently set by Thiel
from O.B.T.; an Ash,
S 5° W, 46 lks. Rock
checks for bearing and
distance - No suitable
trees for additional B.T.'s
(Didn't have my scribe, any
how)

COUNTY SURVEYOR
DOUGLAS COUNTY, OREG.

FEB 21 1953

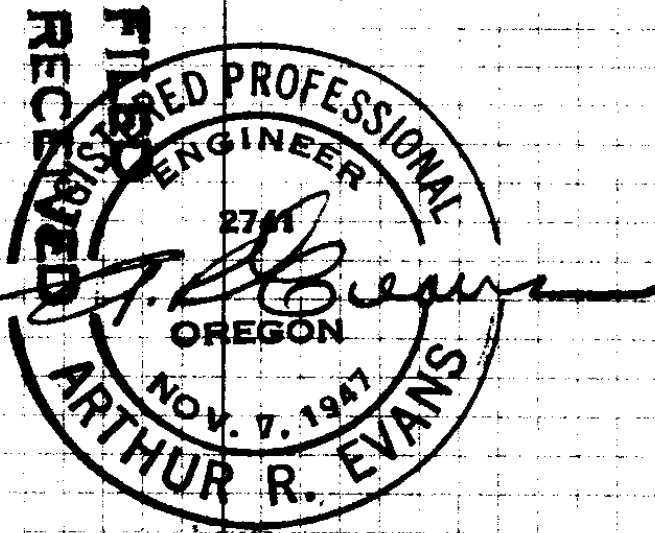

Renewed Byron JAN. '58
44-114

Pg. 2268 Vol. 6
22/4