


NOTE: AT SEC COR  $\frac{3132}{615}$ , FOUND A ROCK WITH 'X' APPARENTLY SET BY SOME LOCAL SURVEYOR. FROM ORIGINAL BEARING TREE, AN ASH, S 5° W, 46 LKS. ROCK CHECKS FOR BEARING AND DISTANCE.  
 BEARINGS ARE MAGNETIC, BASED ON A VARIATION OF 20° 00' E

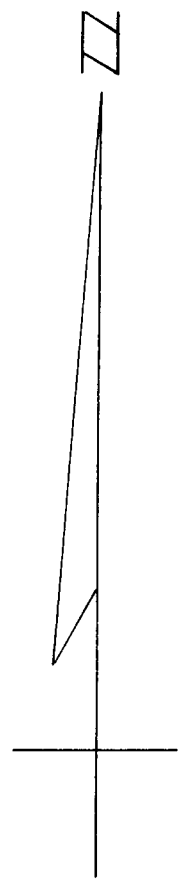

**SURVEY FOR DEED DESCRIPTION  
 IN SECTION 6, T 235, R 4 W, W. M.  
 DOUGLAS COUNTY OREGON**

GRANT AND EVANS, ENGINEERS  
 ROSEBURG, OREGON  
 SURVEYED 2-4-53, SCALE 1"=100'

*Arthur R. Evans*

FILED  
 RECEIVED

FEB 21 1953

COUNTY SURVEYOR  
 DOUGLAS COUNTY, ORE.

**COUNTY SURVEYORS FILE DATA  
 DO NOT REMOVE FROM OFFICE**