


N.E. Cor. Sec. 16.

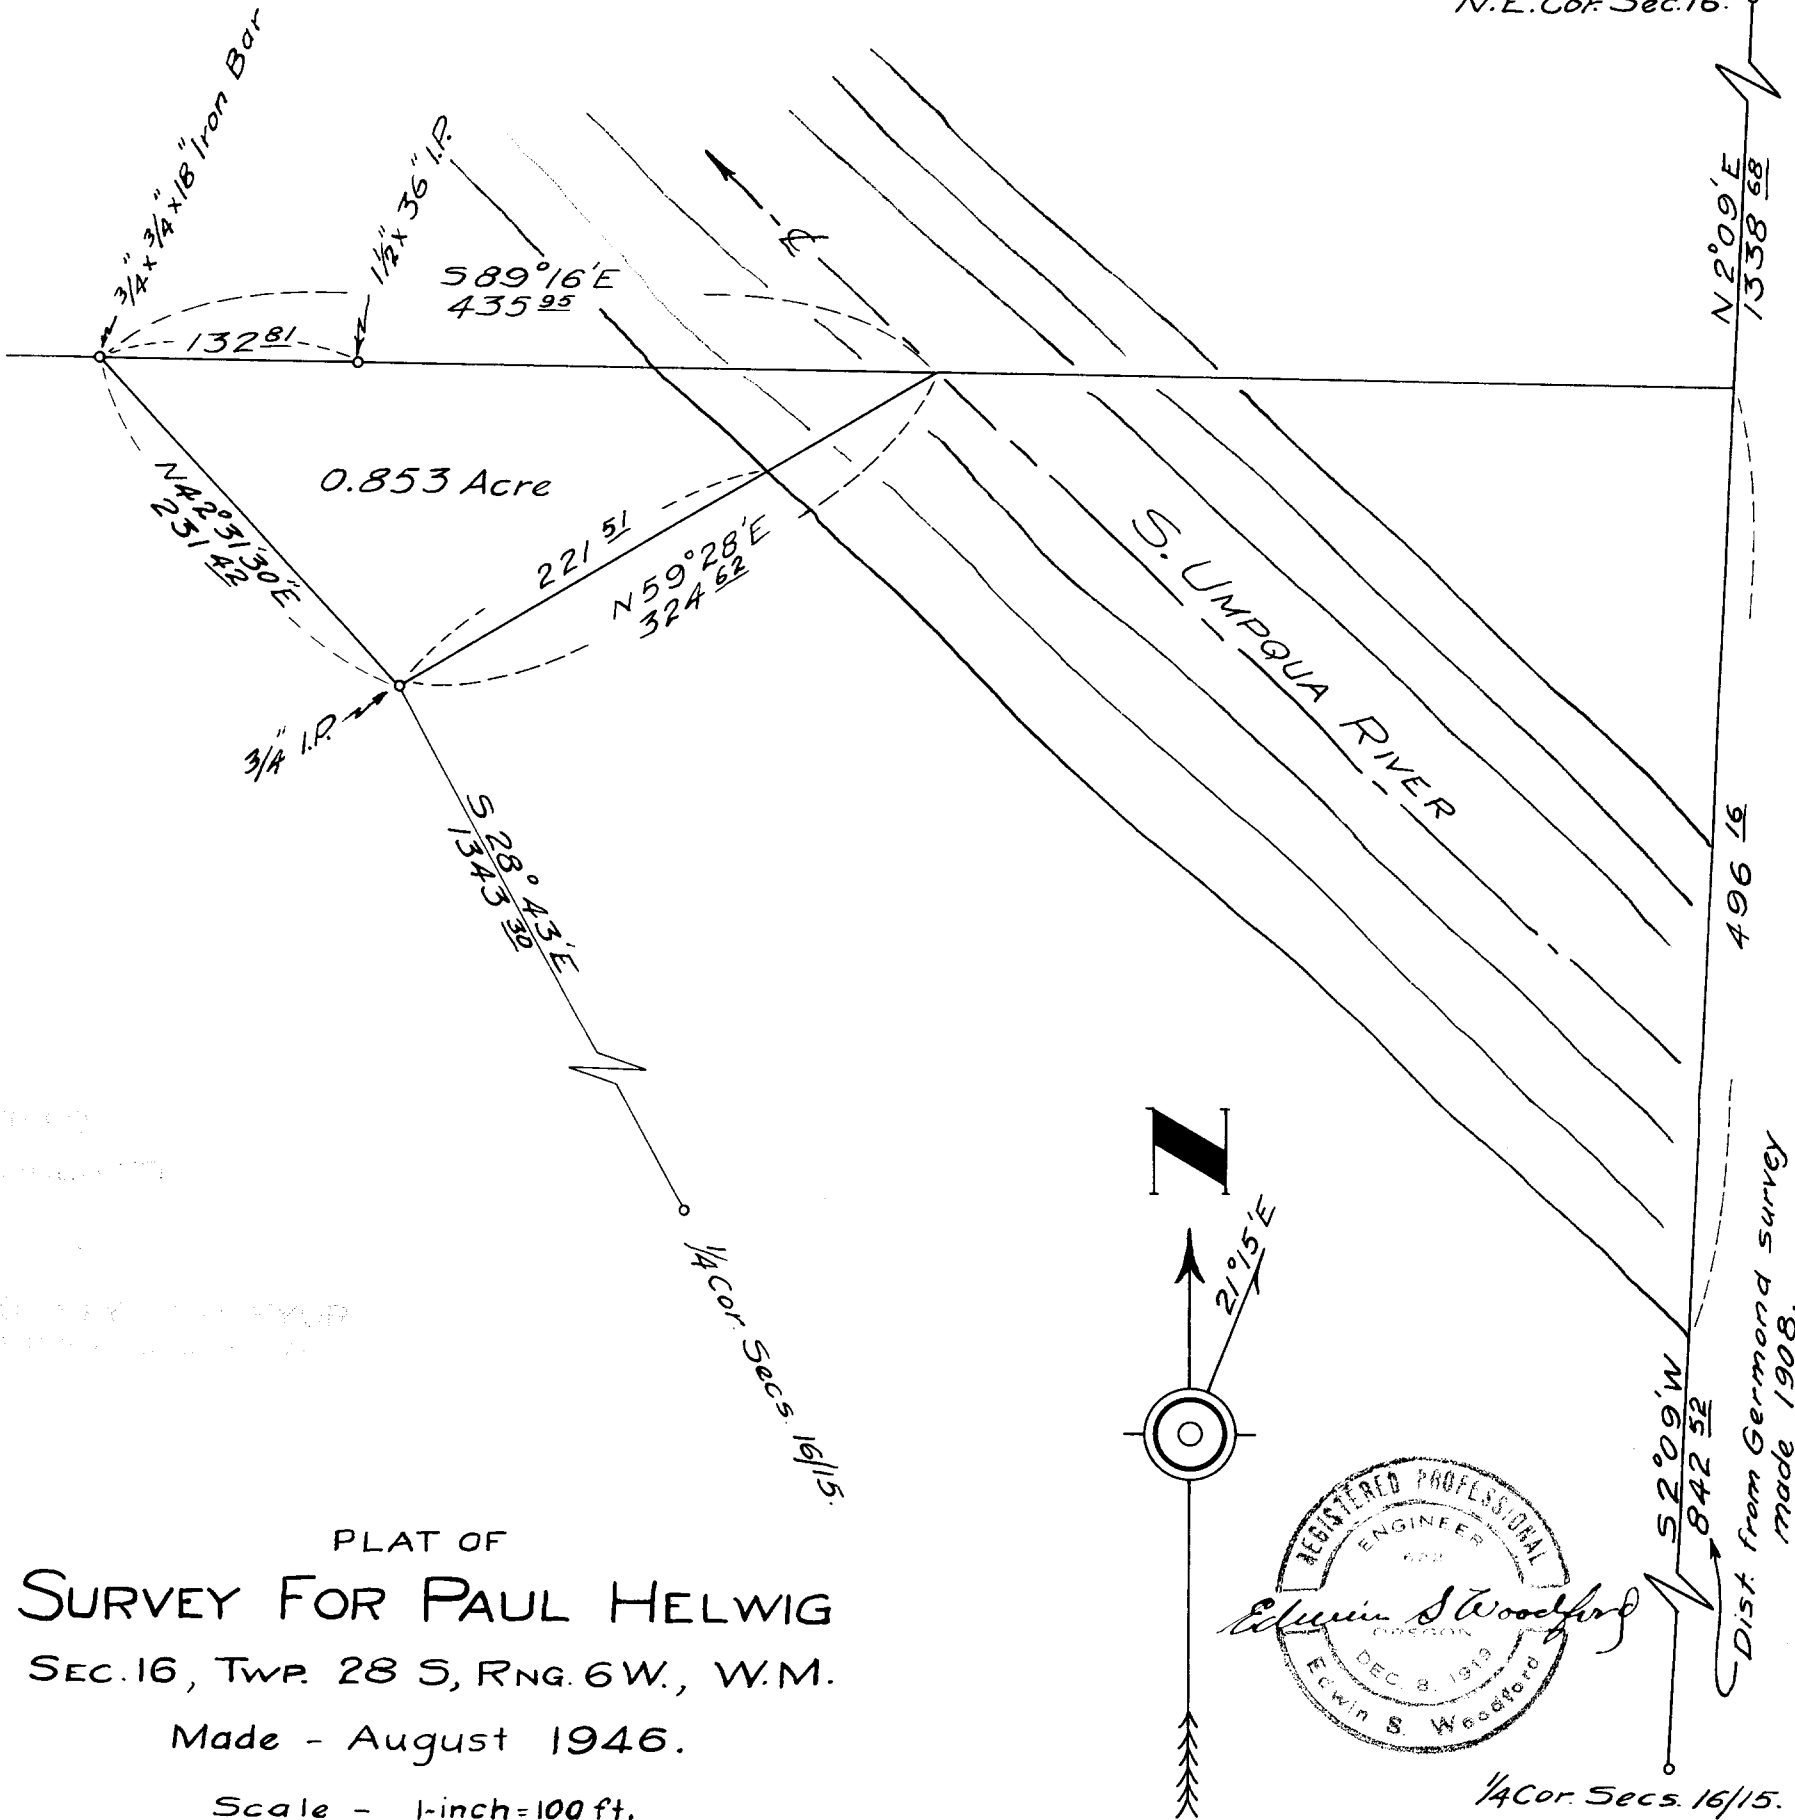

PLAT OF  
**SURVEY FOR PAUL HELWIG**  
 SEC. 16, TWP. 28 S, RNG. 6 W., W.M.

Made - August 1946.

Scale - 1-inch = 100 ft.

**COUNTY SURVEYORS FILE DATA  
 DO NOT REMOVE FROM OFFICE**

1/4 Cor. Secs. 16/15.

CS FILE FOLDER

CONTAINS

MORE

INFORMATION