

3-29-53

North east Corner Section
- 24, T30S, R5W, W.M.

as determined by O.B.T.
A W.O. Stump 36" diam.
bears $S 86^{\circ} W$ 121.0' distance
I fd. scribe.

A B.O. 48" diam. bears North
87.0' dist. O.B.T.


At corner point, found
large stone & 1" iron rod.
from which

A 48" B.O. bears North 87.0'
dist mkd. S.B. B.T.

A Fence bears North &
East from Cor.

Witness:

D. T. Combs

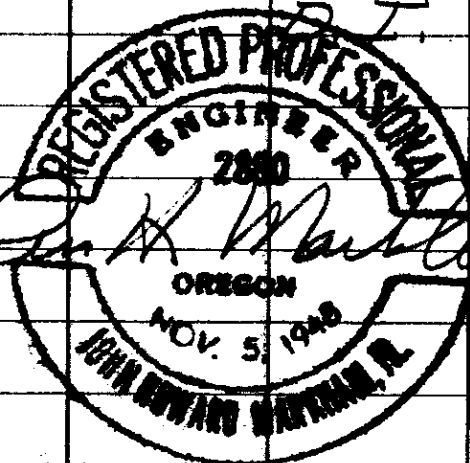

Work done for D. T. Combs.

41/104
1401