

Bearings by Solar observation

FILED
RECEIVED

JUN 4 1953

COUNTY SURVEYOR
DOUGLAS COUNTY, ORE.

REGISTERED
OREGON
LAND SURVEYOR

Leland P. Lovejoy
NOVEMBER 16 1949
LELAND P. LOVEJOY
262

Map showing establishment
of 1/4 corner Sec. 5, on North
boundary Twp 32S, R. 1W, W.M.
Douglas County Oregon
Leland P. Lovejoy L.S. - Medford, Ore.
Scale 1" = 200' 3-18-53

Survey Narrative to Comply with Section 87-330

1947 Oregon State Laws

Survey for: Mr. L. E. Gilliam
Ashland, Oregon


Purpose of Survey: To establish North One-Quarter (1/4) corner
Section 5, Township 32 South, Range 1 West,
Willamette Meridian, Douglas County, Oregon.

Survey Location: North boundary Township 32 South, Range 1
West, Willamette Meridian, Douglas County,
Oregon.

Survey Procedure: Found corner monuments as shown on map. Set
3/4" G.I. pipe for Quarter corner monument of
Section 5, in accordance with procedure
prescribed by law.

Leland P. Lovejoy, Registered Land Surveyor

Work completed March 18, 1953

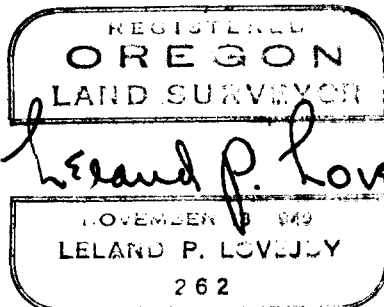

FILED
RECEIVED

JUN 4 1953

COUNTY SURVEYOR
DOUGLAS COUNTY, ORE.

C. S. File No. 41/159 b