

Original Corner of  
DLC. 37. + in rock  
and B.T. Fnd.

R. 7 W.

13 18 Sec. Cor.  
24 19 not found.

pt of beginning  
S 5144.12' & E. 716.99  
from Cor. of DLC. 37  
pipe

S 82° 37' E  
713.0

N 25° 59' E  
257.3

1 SEC. LINE

pipe

BINDER  
59

Hub

3916  
58° 00' W


T. 22 S.

810.52  
N 10° 49' W

pipe

FILED  
RECEIVED

SURVEY  
GEO. A. BINDER  
IN  
NW 1/4 SEC. 19 T. 22 S. R. 7 W. W. M  
DOUGLAS COUNTY  
Scale 1" = 100' Oct. '50.

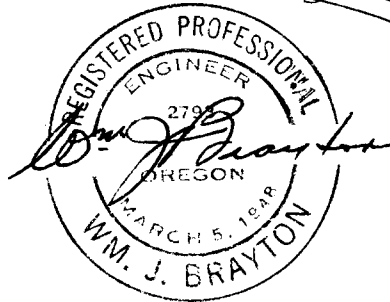

JUL 23 1953

COUNTY SURVEYOR  
DOUGLAS COUNTY, ORE.

COUNTY SURVEYORS FILE DATA  
DO NOT REMOVE FROM OFFICE