

8-15-53

Renewal of Renewal

North east Corner of D.L.C.
37, T305, R3W, W.M. as
determined by 2" iron pipe
set by C.S. in 1918.

At corner point found 2" I.P.
from which.


A B.O. 16" diam. bears $556^{\circ}W$,
141.8' dist. mkd. D.L.C. #37, B.T.

A W.O. 12" diam. bears $514^{\circ}W$
170.0' dist. mkd. NE 37, B.T.

Fences run N-S-W from Corner

Witness:

Dennis Vaughn.

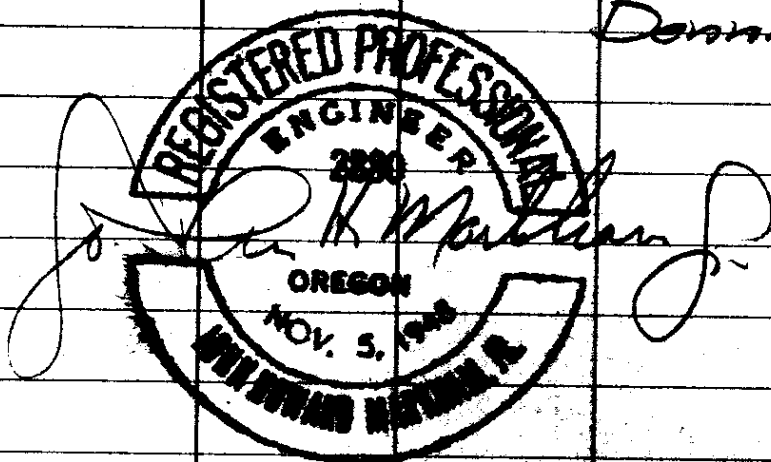

Work done for Mrs. Pat Snow.

CS 41/185