


Found River Boulder, set on end,
 4" x 6" x 16" ← Drove 3/4" Iron Pipe at Rock
 NE Cor Vanderbosch
 ARTHUR BOYER D.L.C. 47
 ROSEBURG, OREGON T.30S; R.6W.

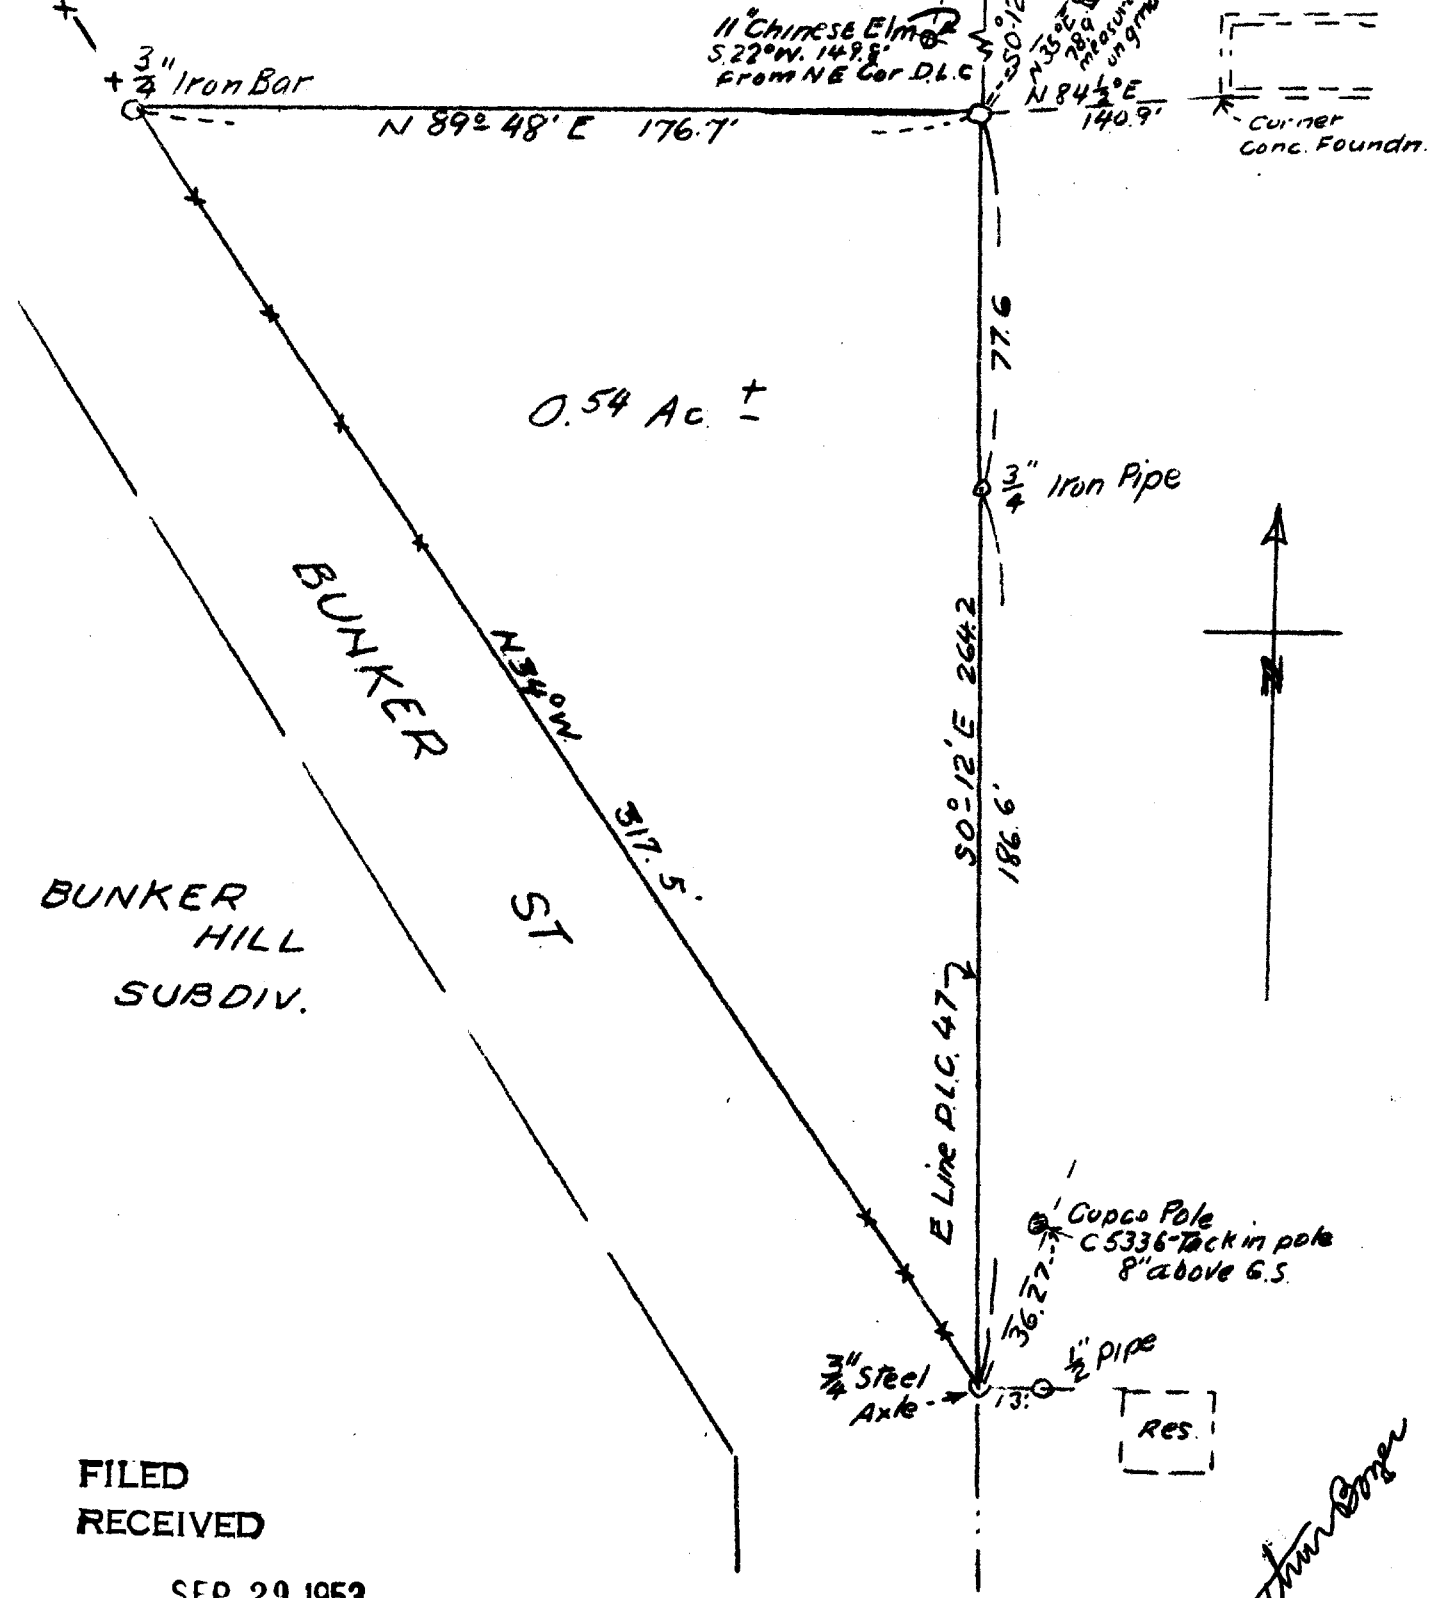

FILED
 RECEIVED

SEP 29 1953

COUNTY SURVEYOR
 DOUGLAS COUNTY, ORE.

COUNTY SURVEYORS FILE DATA
 DO NOT REMOVE FROM OFFICE

RALPH PADDICK
 RIDDLE, ORE.

IN VANDERBOSCH D.L.C. 47, T.30S; R.6W
 SEPT. 1953 *ABoyer* 1"=40'

ORE LIC. 1581. MAY 1933

Arthur Boyer