

Represented by local residents as the N.W. Cor. D.L.C. 47

Measured to rock at NE Cor, 3502' - (Govt notes, 54.1 chs. = 3570.6') measures 68.6' shorter

N. Line D.L.C. 47

160/338

132/438


BUNKER HILL SUBDIVISION

1" = 200'

172/581 109/172
Mealer to Hausseter

NE COR. D.L.C. 47
This ties to rock
53 ch = 349.8' to
47 ch = 310.2' to
46 ch = 301.4' to
48 ch = 309.5' to
1/4 104/1545
unable to check -
cannot determine
co. road line.

Found River Boulder 4' x 6' x 16' - placed on end - Basalt Rock. Indications are it was not moved since being set - Measurements from existing dead points to W. center of rock. Chained for B.M. to E. - unable to locate them.

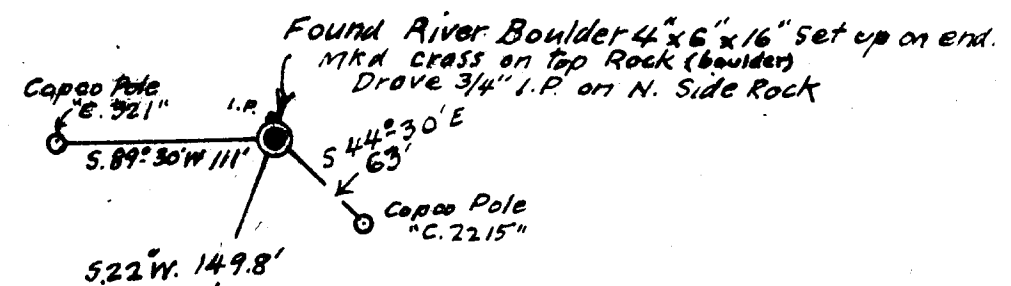

Arthur Boyer
with Ralph Paddock
{ Hans Hausseter }
Sept. 11, 1953

NE COR. D.L.C. 47 (Vanderbosch)
T.30S; R.6W. (Riddle)

**COUNTY SURVEYORS FILE DATA
DO NOT REMOVE FROM OFFICE**

FILED
RECEIVED

SEP 29 1953

COUNTY SURVEYOR
DOUGLAS COUNTY, ORE.

NE COR. VANDERBOSCH D.L.C. 47
T.30S; R.6W, W.M.

Sept. 1953 1963. 1" = 200'