


4/19/97

Ben - I renewed
the following

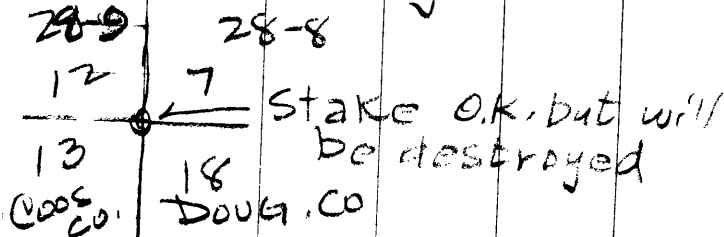

Corner of sections 7 & 18
T. 28-8 & 12 & 13 in 28-9

One Orig. 6' Fir N. 35° E. 14 LKS
marks very plain will have
to be cut due to widening
Coos Bay Wagon Road

I set 6' Fir S. 75° 30' E. 26 1/2 ft.
S 18. T. 28-8 CS BT.

a 5' Fir already set by
Timber Engr. S 15° 30' W. 43 1/2 ft

10-27-53 RECEIVED

F. C. Frear - Surv.


Elmer Metzger, Wrt. OCT 28 1953

Noble Standle COUNTY SURVEYOR
DOUGLAS COUNTY, ORE.

4/1/97

MEMORANDUM *from the desk of*

4/1/77

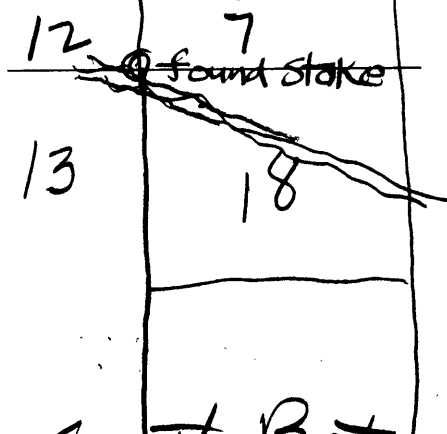

DATE
T. 28-8

5787-U114

South Bet 7 + 12

57.95 Foot Rocky Precipice
80.00 Cor 7-18-12-13

- 30" Fir N. 65W. 57KCS Gone
- 60" " N 35E 14" found - will be cut
- 6" Vine Map. S. 38W. 53" Gone
- 6" " " S. 80E 30" Gone

South Bet 18 + 13

7.75 Branch 25#Ro. @ N. 10W

TIMBER STRUCTURES, INC.

EUGENE OFFICE
P. O. Box 549
Eugene, Oregon



MAIN OFFICE
N.W. 29th and Yeon Aves.
P.O. Box 3782
Portland 8, Ore.

OFFICES FROM COAST TO COAST

6' Fir S75½E

S18-7-265#
28-8

5' Fir

S27½W-43E

already marked
amer
water

10/27-53