

10-9-53

1/4 Section Corner between
15 and 16, T29S, R5W, W.1N
as determined by single
proportional measurement.

At midpoint on section
line I set 1' x 30" I.P.

from which

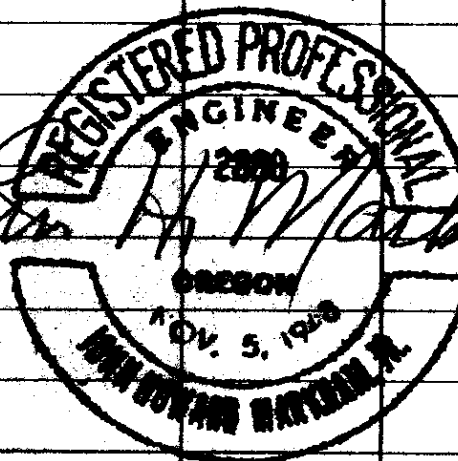
A 16" Fir bears S 51° W 83'
dist. mid. 1/4 S 16 B.T.

A 18" Fir bears N 35° E 15.1'
dist. mid. 1/4 S 15 B.T.

Corner lies on N.E. slope
approx. 400' East of Ridge
Sec Cor lie N 2214.3' + S 2214.3'

Work done by John Seasons
Witness: Earl Stonerod.

2-86/14
4/198-2


John H. Matlock

Work done for Earl Stonerod.