
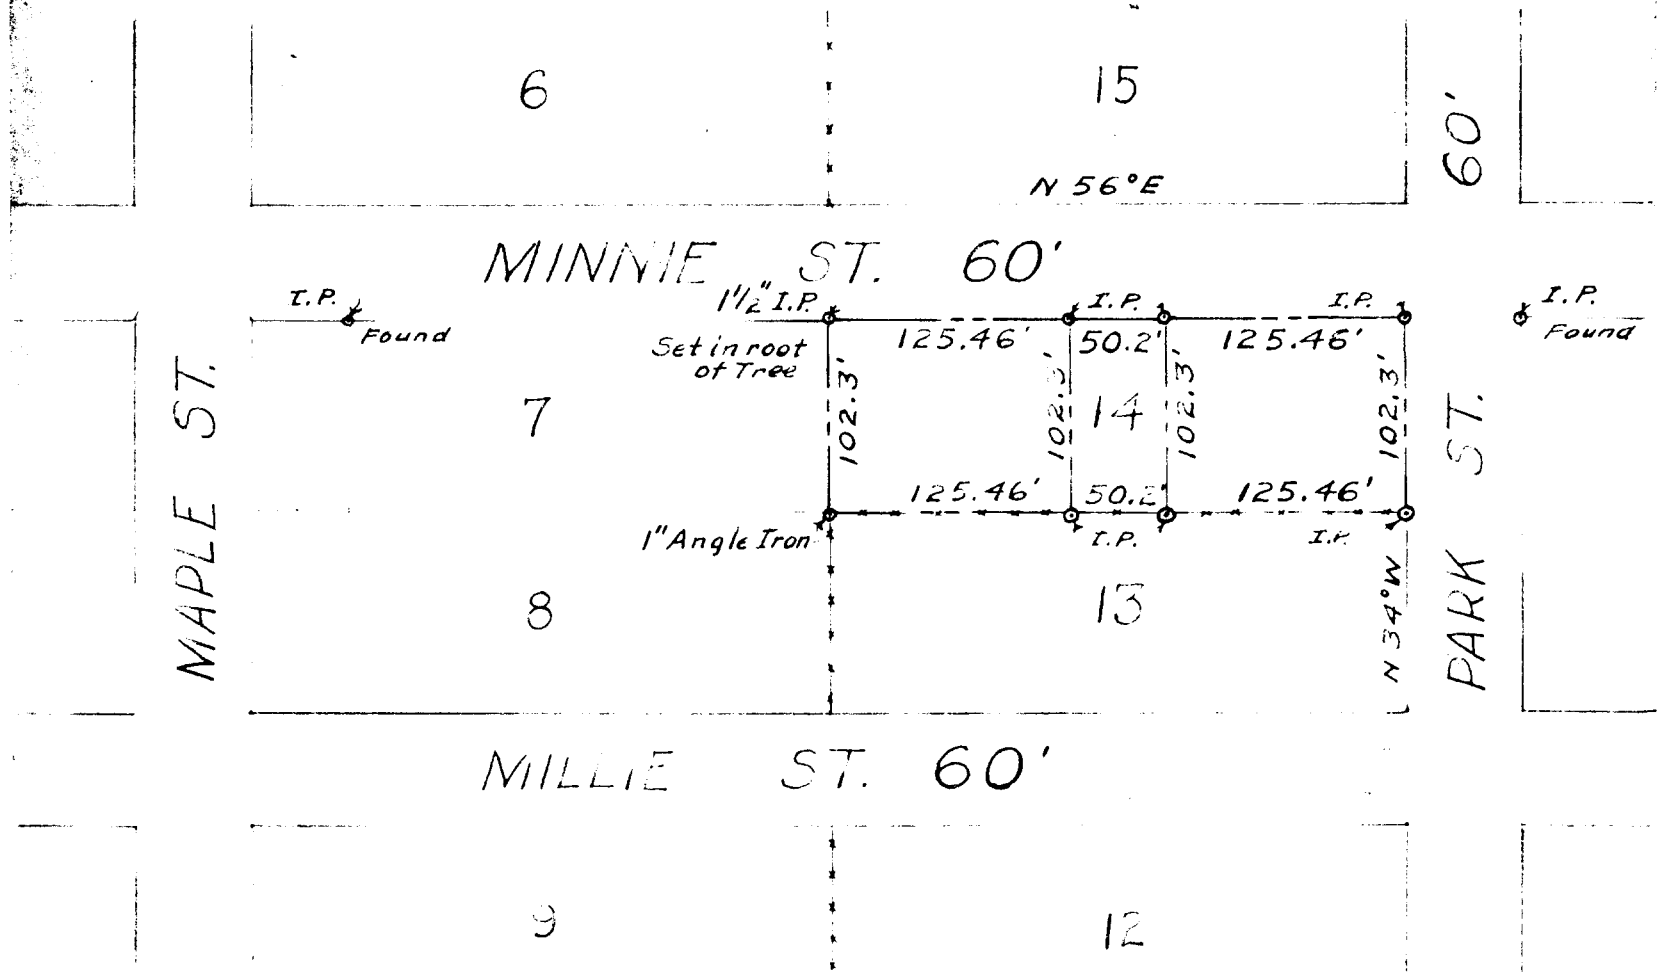


MAP OF SUBDIVISION OF
LOT 14 MAPLE PARK ADD.
 RIDGLE · ORE.

SURVEYED & PLATTED BY
JAMES R. DAUGHERTY
 CIVIL-SANITARY ENGR.
 REGISTERED PROFESSIONAL ENGINEER
 ROSEBURG · ORE.

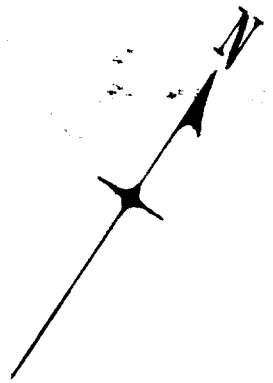

SCALE 1" = 100'

J. R. Daugherty

July 1948