

SEE
Vol 3-271

Aug 8-9-1926


T 275 R 5W Sec 18

Brush

Lines Lots 8 & 9 Block 4

Crescent Heights Add to Roseburg

H L Epstein Surveyor

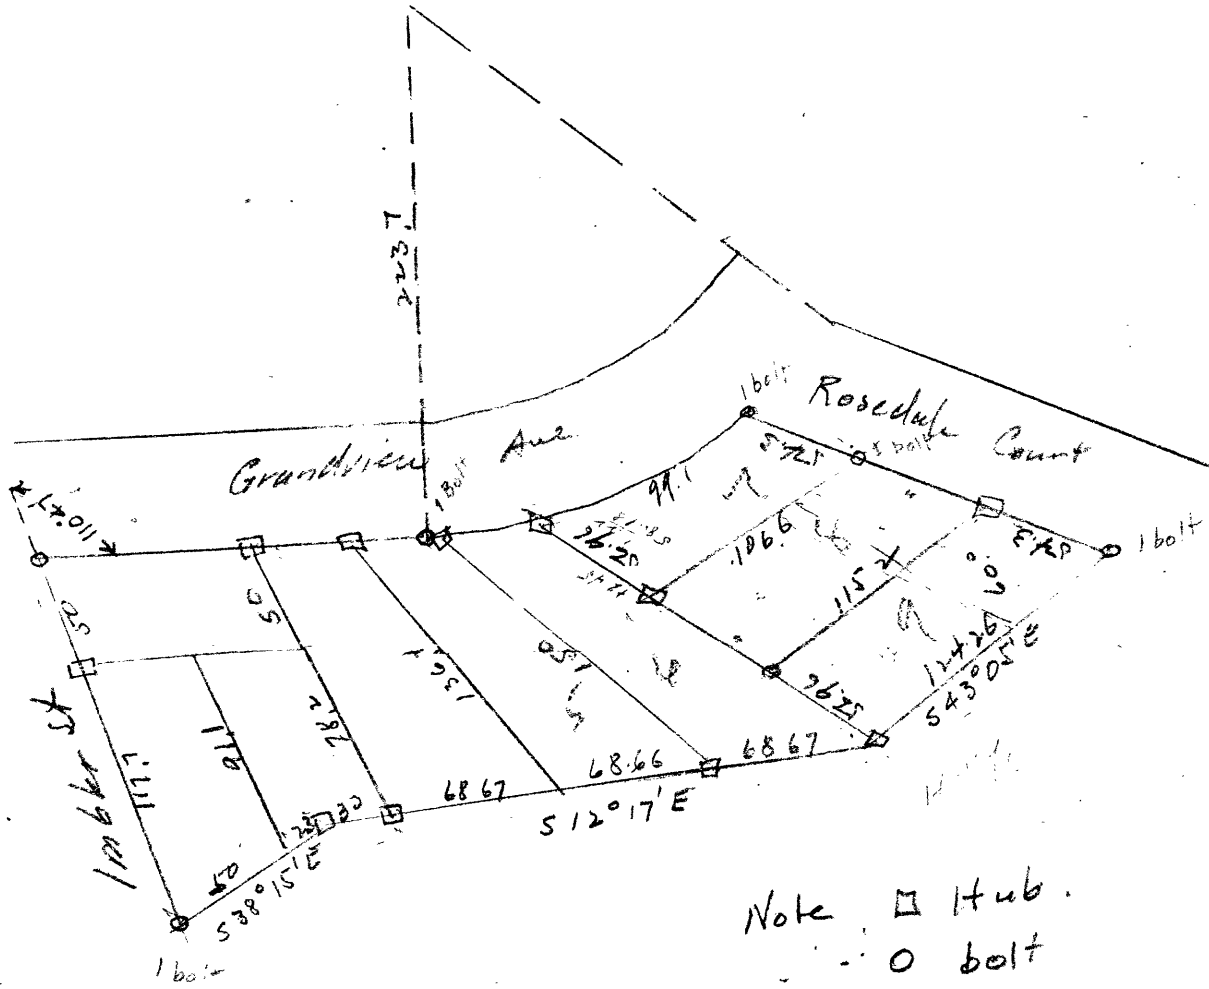

Note □ Hub.
○ bolt