

Renewed Cor.

24/25 T305-R7W  
35/36

Reset from O.B.T's

Fir - N.W.

Fir Stump - S.W.

Old Cor. Post

Set 4" x 4" x 48" Fir Post

3 B.T's

8" Live Oak N20 E, 10.3 ft

Mkd T305-R7W, S25-R5.274 BT

6" L.O. S68 1/2 E, 11.8 ft

Mkd T30-R7 S36-


6" L.O. S11 1/2 W, 16.4 ft

T30-R7 S-35

Wcf:

G.E. Johnson

Merle Evans

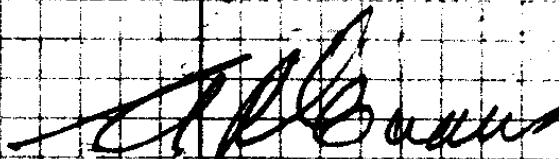

Aug. 15-53

For J.P. Davis

FILE 4/253-