

Renewed Cor.

$\frac{1}{4}$ Cor. 25-36
T 30 S - R 7 W.

Reset from O.B.T.

30" Madras N 30 W, 147.0 ft.

Set $\frac{5}{8}$ " Iron Rod - N B T.

18" Pine, S 10 W, 4.0 ft


Mkd $\frac{1}{4}$ S - 36 - RE 2701 B T.

Wit.

M. B. Evans

T. S. Harris

7-16-53.

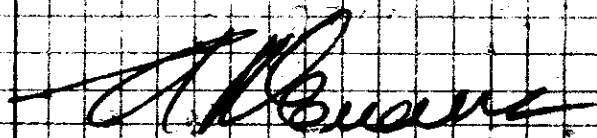

For S. P. Davis

FILE 41/253-2