

NOV

7 1953

Sec. Cor. 25-26-35-36 T305
R7W, W.M. as det. by O.B.T.

A 30" Fir stump bears S67°W
51.0' dist. O.B.T.

A 40" Fir bears N74°W 47.5'

A L.O. stump bears N27°E 8.8'

A L.O. stump bears S63°E 9.0'

At corner point fd. large
pile of stones & scribed post.
from which ~~the~~


A 6" L.O. bears S60W, 11.1'
dist. mkd. T305, R7W, S36, B.T.

A 9" L.O. bears N24°E 9.7' dist.
mkd. T305, R7W, S25, B.T.

A 6" L.O. bears S3W, 16.0' dist.
mkd. T305, R7W, S35, B.T.

Witness:

N.J. Guse

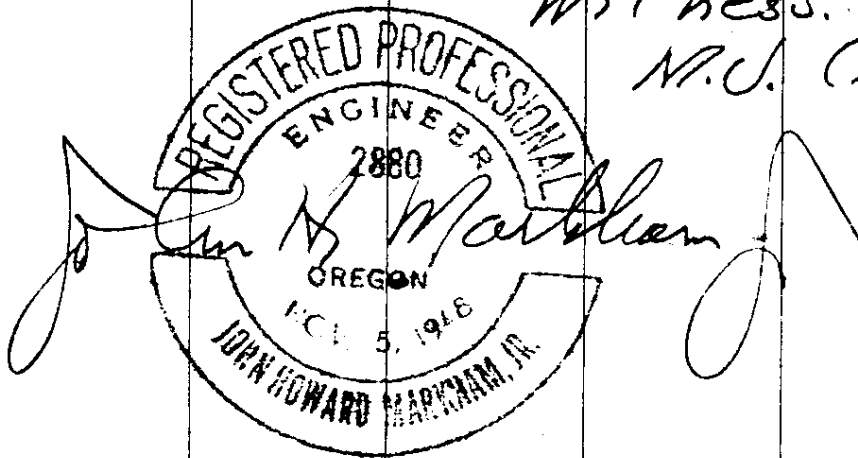

Work done for N.J. Guse

SUR. FILE 41/254-2