

1/4 Cor 11 & 14 - T. 28-8

found 1 1/4" Rd. Axle

Set by EDD. 1936

Recorded V. 1-116

I mark

10" Madrone S11-B.T. N53°E. 23.6

14" R. Fir S14 B.T. S. 15°E. 49.6

March 24-1954


Frear Δ

D. Owens Ch.

Ray Johnson Ch

W. Stubbs

Wm. Cooper

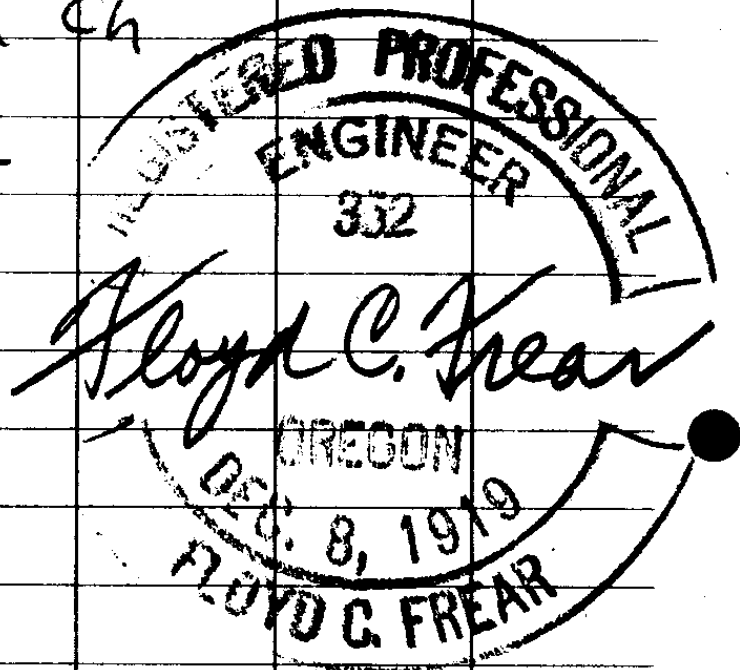

FILE 41/270