


COUNTY SURVEYORS FILE DATA

SURVEY TO ESTABLISH PROPERTY LINES
 LOTS 1-4, BLOCK TWO, BOGARDS ADDITION
 TO ROSEBURG, OREGON
 TIDE WATER ASSOCIATED OIL COMPANY

GRANT & EVANS ENGINEERS
 ROSEBURG, OREGON
 RESURVEYED FEB., 1954 SCALE 1"=20'

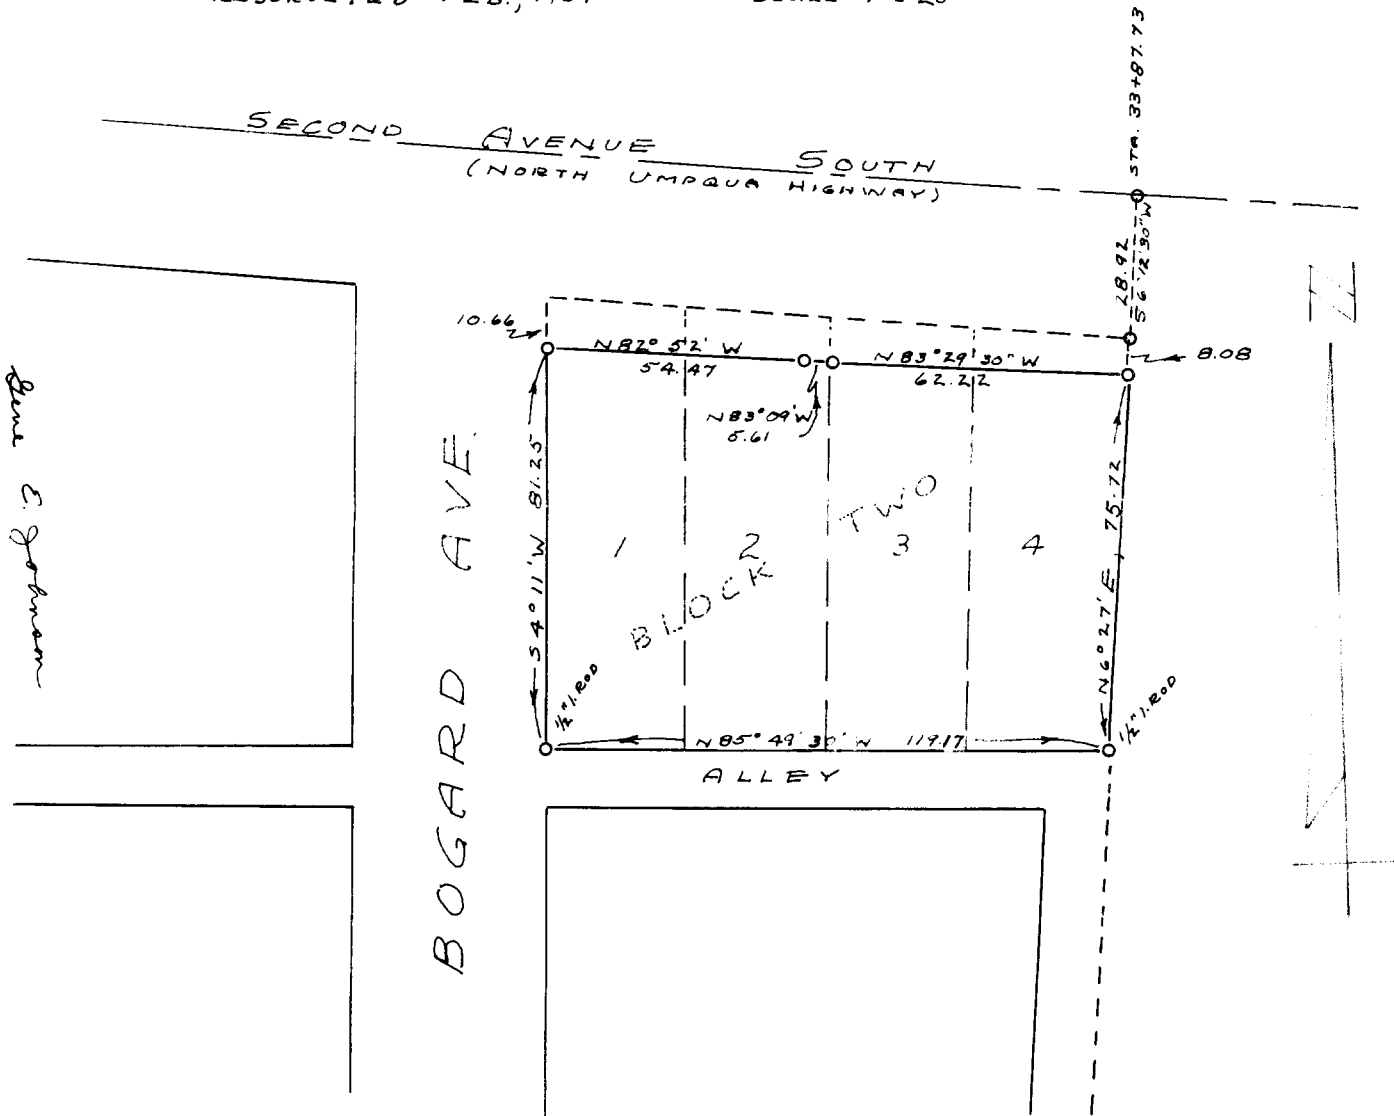

NOTE: BEARINGS ARE BASED ON HIGHWAY BEARINGS OF EAST LINE OF BOGARDS ADDITION - $32^{\circ} 37' W$ - CORNERS ON NORTH LINE FALL ON EDGE OF SIDE WALK SO WITNESS PIPES WERE DRIVEN SOUTH OF TRUE CORNER POINTS