

FILED
RECEIVED


OCT 4 1954

COUNTY SURVEYOR
DOUGLAS COUNTY, ORE.

COUNTY SURVEYORS FILE DATA
DO NOT REMOVE FROM OFFICE

SURVEY FOR DEED DESCRIPTIONS
IN LOT 5, "CEDAR GROVE"
D.L.C. No. 44, T27S, R4W.WM.
DOUGLAS COUNTY OREGON

GRANT AND EVANS, ENGINEERS,
ROSEBURG, OREGON
SURVEYED, JULY, 1954, SCALE 1"=40'

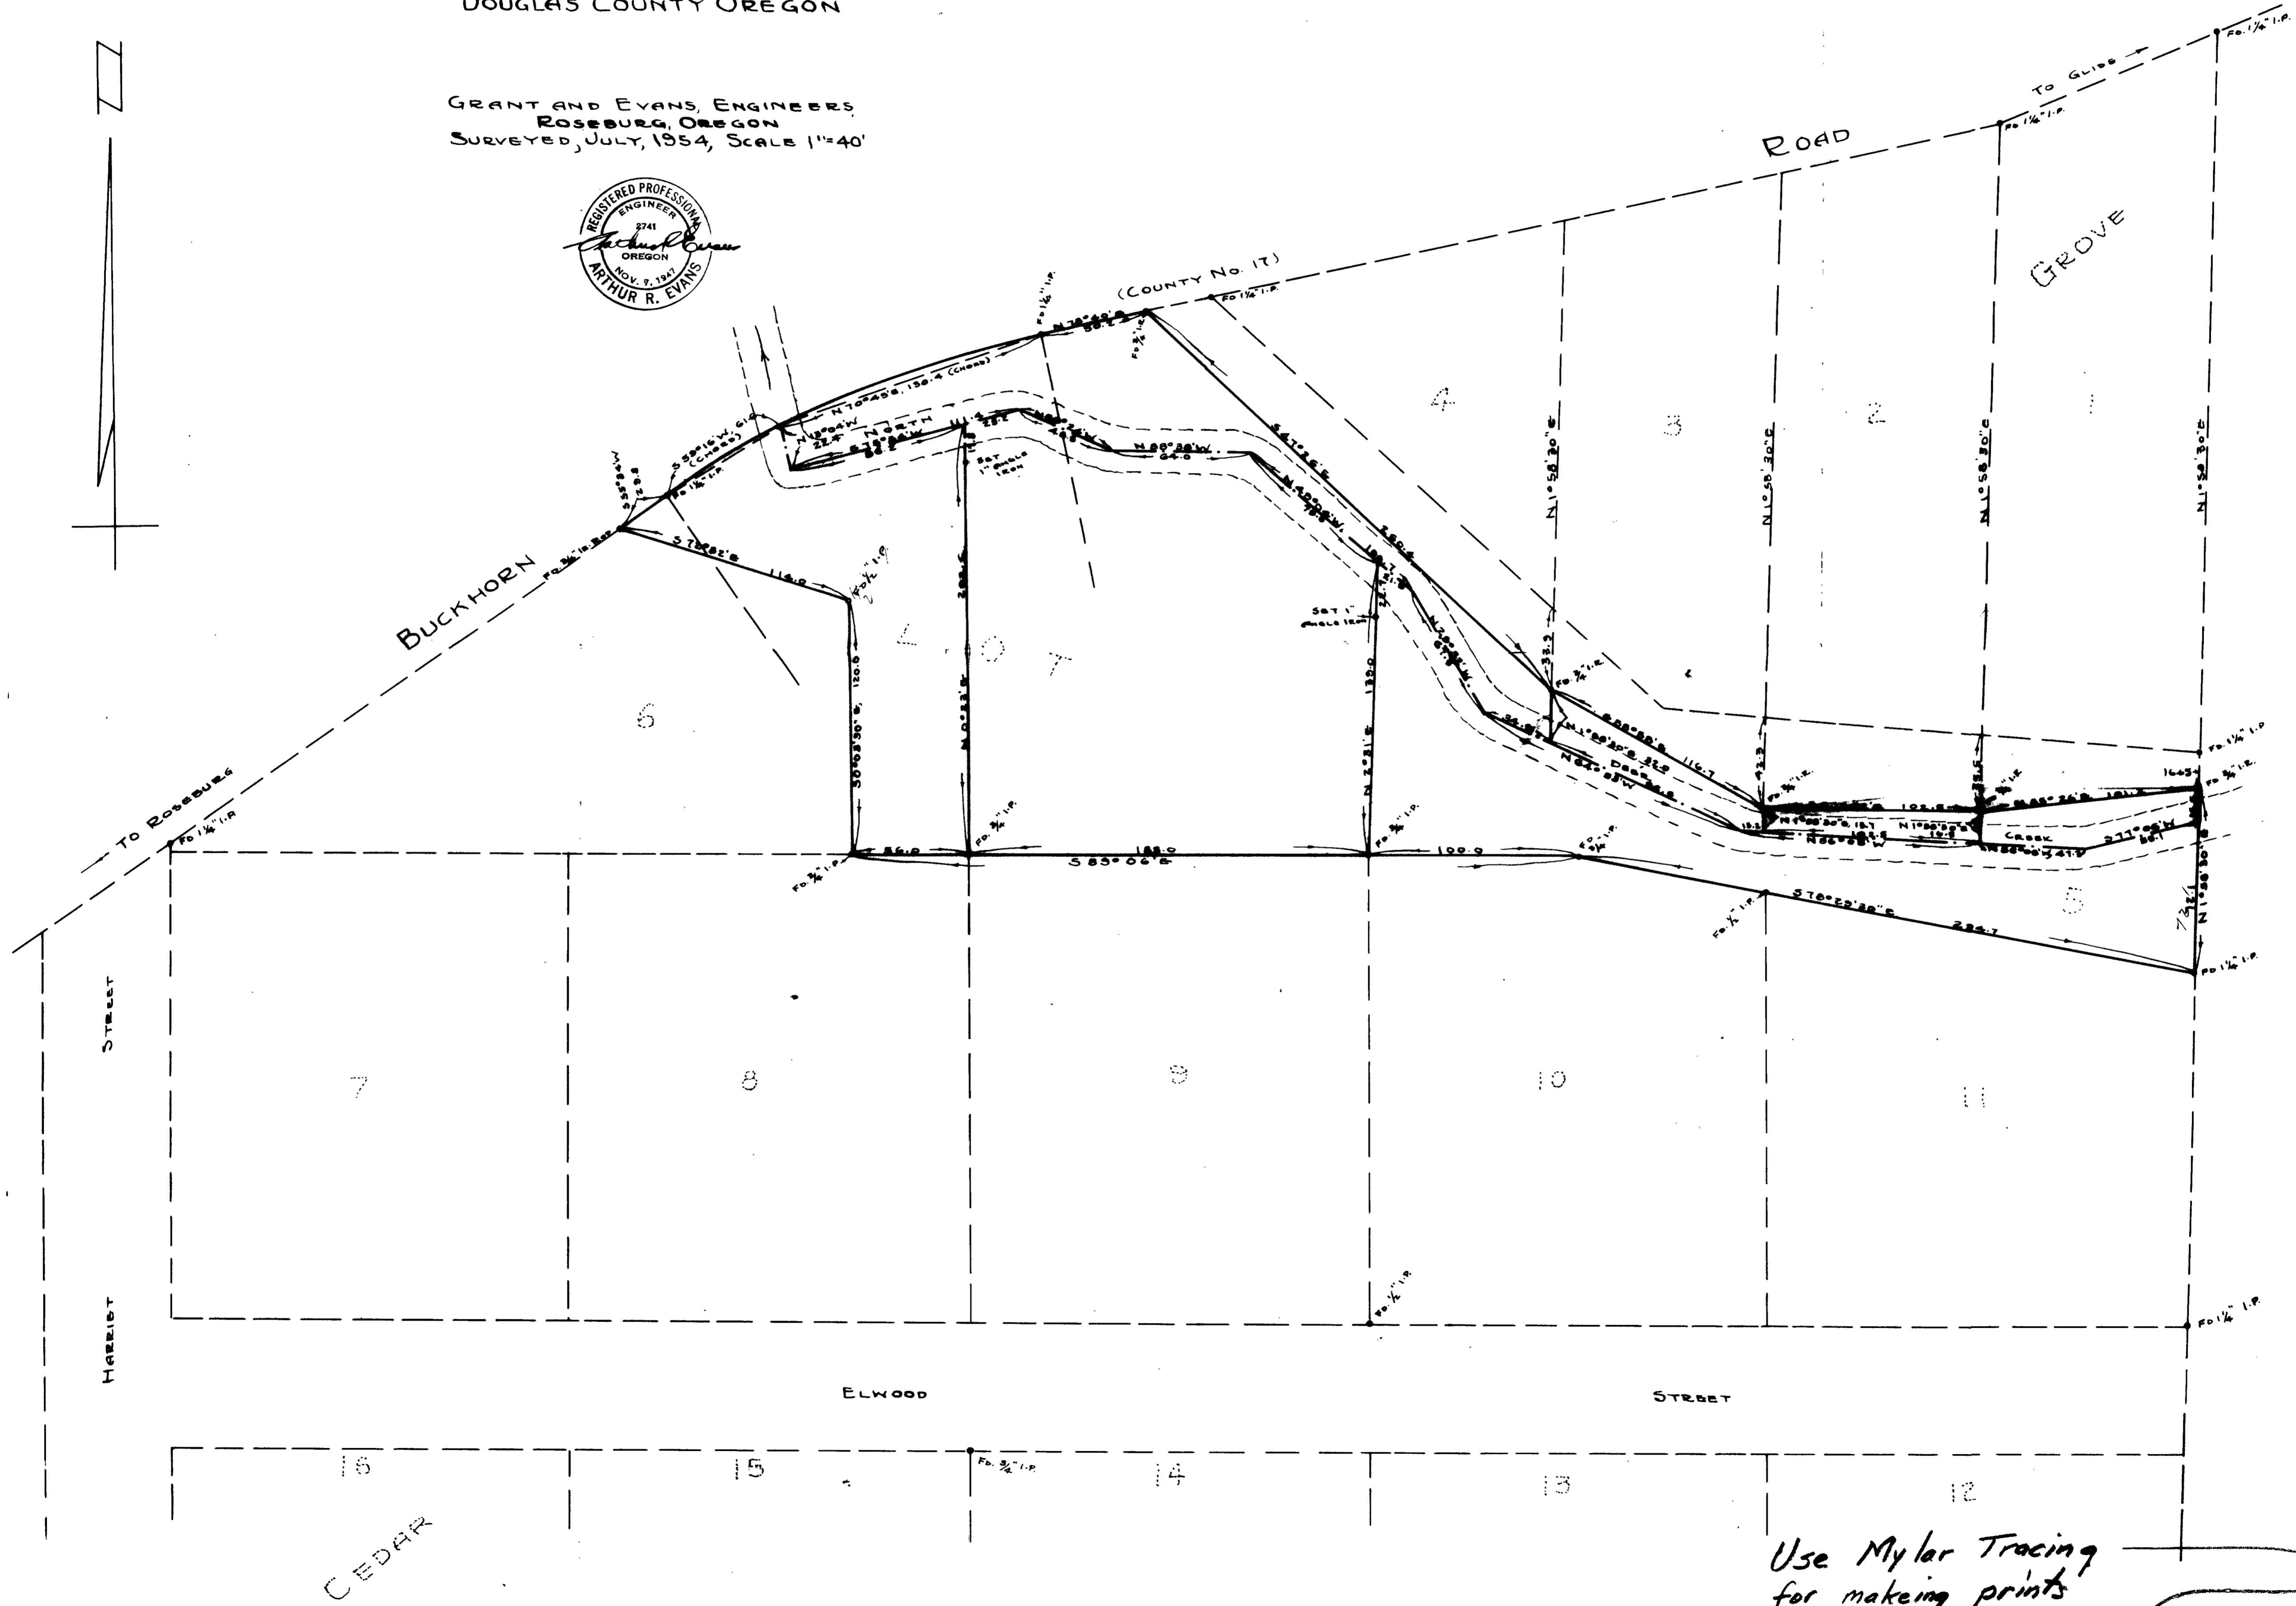

Use Mylar Tracing
for making prints

