



SURVEY for WILLIAMSON LOGGING Co.
IN

Section 18; Twp. 21 S.; R 5 W. W. M.
Scale: 1" = 400' Nov. 1954

FILED
RECEIVED

NOV 16 1954

COUNTY SURVEYOR
DOUGLAS COUNTY, ORE.

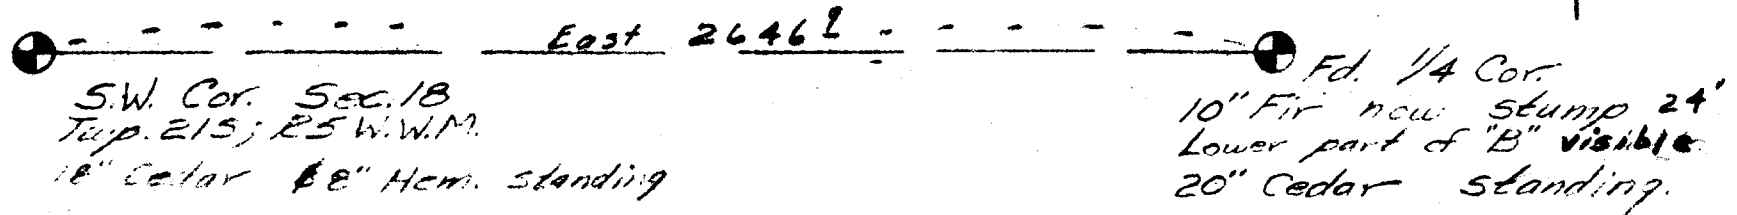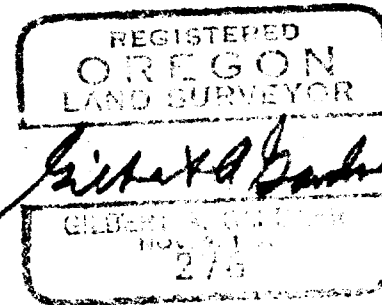

COUNTY SURVEYORS FILE DATA
DO NOT REMOVE FROM OFFICE

C.S. FILE #1/315