

July 28, 1954

Section Corner 5, 6, 7 & 8,
T335, RAW, W.M. as det-
ermined by O.B.T.'s

A 26" Y.P. Snag bears
S 49° E 11.0' dist. found scribe.

A 38" Y.P. bears N 5° E 33.0'

A 16" Y.P. bears N 77° W 73.0'

At corner point found
stone & made a large pile
of stones.


from which

A 10" Y.P. bears S 55° W 120.0'
dist. mkd. 57, B.T.

A 9" Fir bears S 45° E 20.0'
dist. mkd. 58 B.T.

corner lies on top of ridge
at the East end of rocky
opening.

Witness: Geo. Blomgren

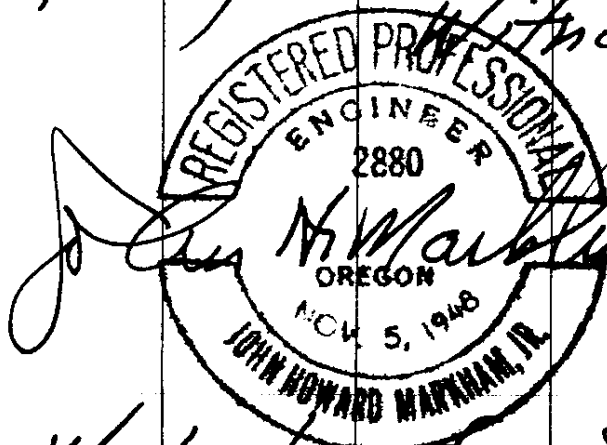

Work done for Stoman Lbr. Co.
CS. 41/322