

T235, RTW
3 2 T245, RTW

C.C. SECS 2 & 3, T245, RTW
FO 2 O.B.T.S.
24" FIR (NOW 36" STUMP) S60°W, 63 LKS
15" FIR - S70°E 48 LKS
SET 4" X 4" X 48" STAKE, BL & SCR N.B.T.
16" FIR, S60°E, 41.1 FT. MKD. T245 RTW, C.C. S-2-B.T.
24" FIR, S30°W, 56.0 FT. MKD. T245, RTW, C.C. S-3-B.T.


NORTH (RECORD) 5002.9 = 75.65 CHS (REC.)
1322.6 = 1320. (REC.)

1/4 COR. SECS. 2 & 3.
SET BY PROP. M.B.S.
SET 4" X 4" X 48" FIR STAKE.
BL & SCR. 2 O.B.T.S.
1" X.O. S55°E, 79.6 FT. MKD N 1/4 S-2 B.T.
4" X.O. N25°W, 80.8 FT. MKD N 1/4 S-3-B.T.

1/4 COR. SECS. 2 & 3
SET BY PROP. M.B.S.
SET 4" X 4" X 48" FIR STAKE.
BL & SCR. 2 O.B.T.S.
1" MYRTLE, S85 1/2°W, 25.1 FT. MKD 1/4 S-3 B.T.
1" MYRTLE N36 1/2°E, 52.8 FT. MKD 1/4 S-2 B.T.

N 0°00'30" E = 40.00 CHS (REC.)
2645.3 = 40.00 CHS (REC.)

SEC. COR. RD STEEL SHFT
42 1/2" O.B.T.S.
48" FIR, N23°E, 11 LKS (O.B.T.)
26" FIR, S55°E, 27.1 FT (DOW)
22" FIR, S11 3/4°E, 55.0 FT (DOW)

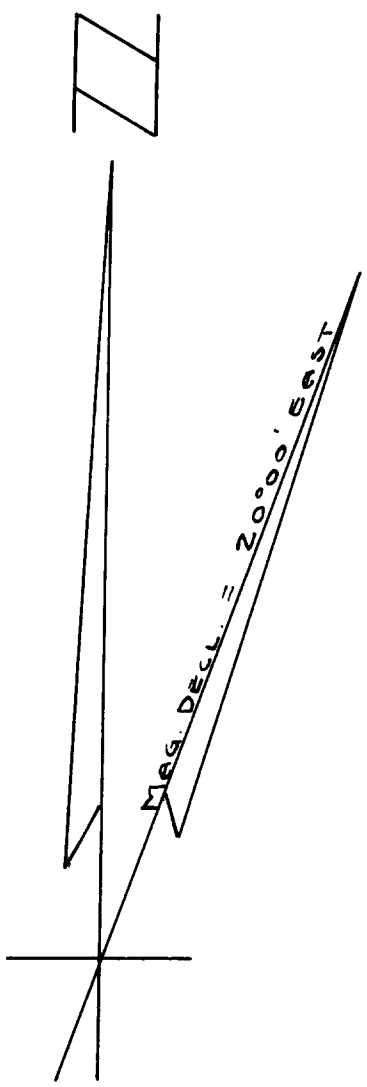

SURVEY TO ESTABLISH CORNERS
ON LINE BETWEEN SECS. 2 & 3
T245, RTW. W. M.
DOUGLAS COUNTY OREGON
FOR L. & H. LUMBER CO.

GRANT AND EVANS, ENGINEERS.
ROSEBURG, OREGON
SURVEYED NOV. 1954
SCALE OF MAP, 1" = 500'


FILED
RECEIVED

JAN 10 1955

COUNTY SURVEYOR
DOUGLAS COUNTY, ORE.

COUNTY SURVEYOR'S FILE DATA
DO NOT REMOVE FROM OFFICE

C.S. File No. 41/330

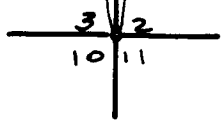

CS FILE FOLDER

CONTAINS

MORE

INFORMATION

N $\frac{1}{16}$ Cor Secs. 3 | 2
T 24 S., R 7 W.

Set 4" x 4" x 48" Fir
Post.

Bl. E. Scr. 2 B.T.S.

8" W.O. S58° E, 79.6 ft
Mkd N $\frac{1}{16}$ S-2, B.T.
R.E. 2741

14" W.O. N25° W, 80.8 ft
Mkd N $\frac{1}{16}$ S-3, B.T.
R.E. 2741.

Witnesses:

Gene Johnson

M.E. Godfrey

A. B. Buss

C. S. File No. 41/334

Closing corner
Sees

3 | 2

T245. R7W.

Set 4" x 4" x 48" Fir
Post.

B. & S. 2 B.Ts.

16" Fir S60°E, 41.1 ft
Mkd T245. R7W, CC. S-2

B.T. R.E. 2741

24" Fir, S30°W, 56.0 ft
Mkd T245. R7W, CC. S-3

B.T. R.E. 2741

Witnesses:

Gene Johnson

H.E. Godfrey

[Signature]

C.S. File No. 41/324

L & H. Lumber Co.

$\frac{1}{4}$ Cor $3\frac{1}{2}$ T 245, R7W.

Set by prop. meas.

Set 4" x 4" x 48" Fir
Stake. Bl. & Scr. 2 B.T.'s.

10" Myrtle, S85 $\frac{1}{2}$ W, 25.1
MKD $\frac{1}{4}$ S-3-B.T. RE. 2741

9" Myrtle N36 $\frac{1}{2}$ E, 52.8
MKD $\frac{1}{4}$ S-2-B.T. RE. 2741

Nov. 11, 1954

Milo Godfrey } witnesses
Gene Johnson }

A. R. Brown

C. S. File No. 41/334