

28-29-32-33

Section Corner to Sections 27, 28, 33, 34
T. 31 S., R. 6 W., W. M.

Found original corner post standing
and in place. Replaced corner with
a 3/4" iron pipe from which bears

Fir - 38" N 15° E 14.5 ft. Scribed 528
in bark - This is original B.T.

Fir 32" N 65° W 13.2 ft. Scribed 529
in bark - This is original B.T.

Fir 10" S 44° E 16.5 ft. Scribed 533
T 31 S R 6 W ^{WM} B.T. - This is new B.T.

Fir 10" S 28° W 23.2 ft. Scribed 532
T 31 S R 6 W WM - This is new B.T.

17-29-54

R. H. GEE

R. J. HENRIKSON

F. M. McCURNACK

FILED

RECEIVED

FEB 5 1955

COUNTY SURVEYOR
DOUGLAS COUNTY, ORE.

C. S. File No. ~~411538~~ - 1


Date 12-29-54

To the County Surveyor
Roseburg, Oregon

Sir:

We have located the government corner noted below and report the following conditions existing as of this date.

T 31 S, R 6 W., W. M.

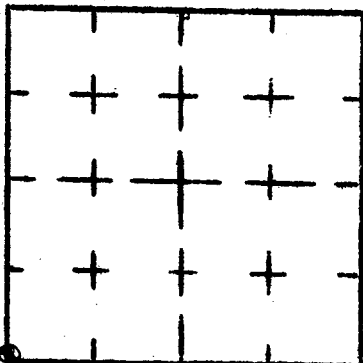

Section 28

How was the corner found and identified?

By Random line from NW Corner of Section

BEARING TREES FOUND

NEW B.T.

NEW B.T.

Quadrant	NE	NW	SE	SW
Species & size	38" Fir	32" Fir	Burned Snag	Stump hole
Dist. & Bearing From Corner	N15°E 14.5 ft	N65°W 13.2 ft	S51°E 32.3 ft	S76°W 29.7 ft
Condition of Scribe or Scar	Fair	Good	Burned off	None
Original or Resurvey BT	Original	Original	Original	Original
Appearance of BT	Cull tree	Healthy	Dead	Gone
Tags, Marks, Etc. on BT	None	Merrill's M	None	None

Conditions of corner and witnesses Original corner post found standing and in place

Best route to reach the corner _____

Other remarks Replaced orig. corner post with iron pipe. picked 2 New B.T.s as follows - 10" Fir S44°E 16.5 ft. scribed S33T315R6W WM B.T. - 10" Fir S78°W 23.2 ft. scribed S34T315R6W WM B.T.

Signed R. W. See
R. J. Hewison
Fred M. Cornwell