

1/4 Corner between Sections 28 & 29
T315R6WWM

B.T. to Section 28 present. Scars
very plain. Reset corner with
3/4 inch pipe using recorded
distance and bearing. B.T.s
are as follows:

Fir 18" East 5.3 ft. - Original B.T.
Incense Cedar 12" S60°-30' W 8.8 ft
Scribed 1/4 S29 T315 R6W WM.
This is new B.T.

12-29-54

R. H. GEE

R. J. HENRIKSON

F. M. McCORNACK

FILED

RECEIVED

FEB 5 1955

COUNTY SURVEYOR
DOUGLAS COUNTY, ORE.

G. S. File No.

41/338¹²


Date 12-29-54

To the County Surveyor
Roseburg, Oregon

Sir:

We have located the government corner noted below and report the following conditions existing as of this date.

T 31 S, R 6 W., W. M.

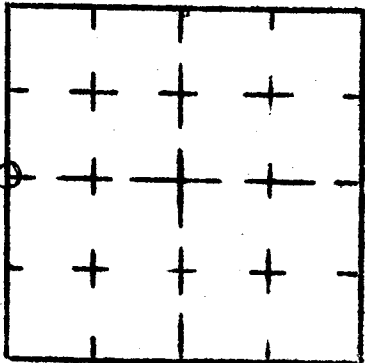

Section 28

How was the corner found and identified?

BY RANDOM LINE SOUTH

BETWEEN SEC'S 28 & 29

BEARING TREES FOUND

MARKED THIS.

Quadrant	EAST NE	NW	SE	SW
Species & size	18" FIR		12" Cedar	
Dist. & Bearing From Corner	EAST 5.3 FT.		560° 30' W 8.8 FT.	
Condition of Scribe or Scar	Both scars in good shape		New	
Original or Resurvey BT	Original		Resurvey	
Appearance of BT	Healthy		Healthy	
Tags, Marks, Etc. on BT	None		None	

Conditions of corner and witnesses _____

Best route to reach the corner _____

Other remarks Put in iron pipe for 1/4 corner from which bears a 12" Incense Cedar 12" in dia which bears 560°-30' W 8.8 FT. Scribed as follows 1/4 529 T 31 S R 6 W W M BT

Signed R. J. Erickson
R. J. Erickson
Fred M. Cornack