

Section Corner to Sections 20, 21, 28, 29  
T 31 S R 6 W N M

Three Original B.T.s present  
from which corner was reset  
using recorded distances and  
bearings - Corner is  $\frac{3}{4}$  inch  
iron pipe from which bears:

Fir 8" N 40° E 11.8 ft. scribed 521

T 31 S R 6 W N M. This is new B.T.

Pine 36 N 40° W 65.3 feet rescribed

520 T 31 S R 6 W N M. - Original B.T.

Fir 48" S 80° E 55.4 ft. rescribed

528 T 31 S R 6 W N M. - Original B.T.

Incense Cedar 38" S 74° W 34.3 ft.

529 T 31 S R 6 W N M visible in

bark. Original B.T.

12-79-5 ↓

R. H. Gee

R. J. HENRIKSON

E. M. CORNAGLIA

FILED  
RECEIVED

FEB 5 1959

COUNTY SURVEYOR  
DOUGLAS COUNTY, ORE.

*[Handwritten signature]*

C. S. File No. 44/338<sup>3</sup>


Date 12-29-54

To the County Surveyor  
Roseburg, Oregon

Sir:

We have located the government corner noted below and report the following conditions existing as of this date.

T 31 S, R 6 W., W. M.

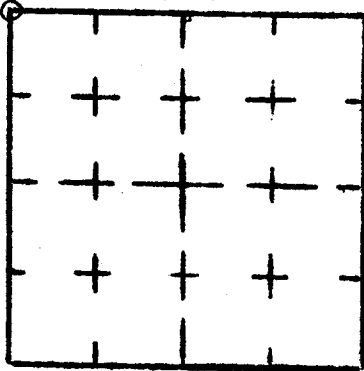

Section 28

How was the corner found and identified?

From B.L.M. Tag on old  
Middle Cr. Rd.

BEARING TREES FOUND

Quadrant	NE	NW	SE	SW
Species & size	Gone	36" Pine	48" Fir	36" Cedar
Dist. & Bearing From Corner		N40°W 65.3	S80°E 55.4	S74°W 34.3
Condition of Scribe or Scar		Very faint	Very poor - Windfall Scar	In bark - Very Plain
Original or Resurvey BT		Original	Original	Original
Appearance of BT		Healthy	Cull tree	Healthy
Tags, Marks, Etc. on BT		One Cruise Mark "B"	None	None

Conditions of corner and witnesses

Best route to reach the corner

Other remarks Put in Iron pipe for corner - Marked 8" Fir for  
New B.T. which bears N40°E 11.8 Ft. Scribed as follows:  
S 21 T 31 S R 6 W W.M. B.T.

Signed

D. W. Lee  
R. J. Newberry  
Fred M. Carnack