

1/4 Cor. between Sections 4 & 5

T31S R6W WM

Found one Laurel B.T. Scribe marks very plain. Tree has fallen over. Reset corner from stump hole using recorded distance and bearing.

Corner is 3/4 inch iron pipe
Marked 2 new B.T.s which are as follows:

Fir 14" N33°W 3.4 Ft. Scribed
1/4 S5 T31S R6W B.T.

Fir 14" S48°-10'W 6 1/2 Ft. Scribed
1/4 S4 T31S R6W B.T.

14-30-54

R. H. GEE

R. J. HENRIKSON

F. M. CORNALL

FILED

RECEIVED

FEB 5 1955

COUNTY SURVEYOR
DOUGLAS COUNTY, ORE.

C.S. File No. 41/338A


Date 12-30-54

To the County Surveyor
Roseburg, Oregon

Sir:

We have located the government corner noted below and report the following conditions existing as of this date.

T 31 S, R 6 W., W. M.

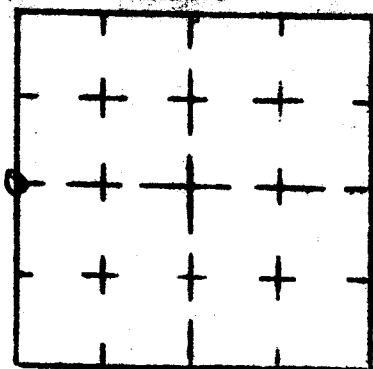

Section 5

How was the corner found and identified?

By RANDOM LINE North from
SW corner Section 5

BEARING TREES FOUND

Quadrant	NE	NW	SE	SW
Species & size			GONG	Laurel
Dist. & Bearing From Corner				$\frac{1}{4}$ S 8 distinct
Condition of Scribe or Scar				distinct.
Original or Resurvey BT				Original
Appearance of BT				Down
Tags, Marks, Etc. on BT				None

Conditions of corner and witnesses _____

Best route to reach the corner _____

Other remarks Down Laurel root hole plain - Reset corner with
iron pipe using center of stump hole and recorded distance
& bearing - Put in 2 NEW B.T.'s which bear from corner as
follows: Fir 14" N33°W 3.4 ft. Scribed $\frac{1}{4}$ S 5 T 31 S R 6 W W M B T
Fir 14" S48°10'E 6.8 ft. " $\frac{1}{4}$ S 4 T 31 S R 6 W W M B.T.

Signed R. J. Harrison
R. J. Harrison
Fred McCannick