
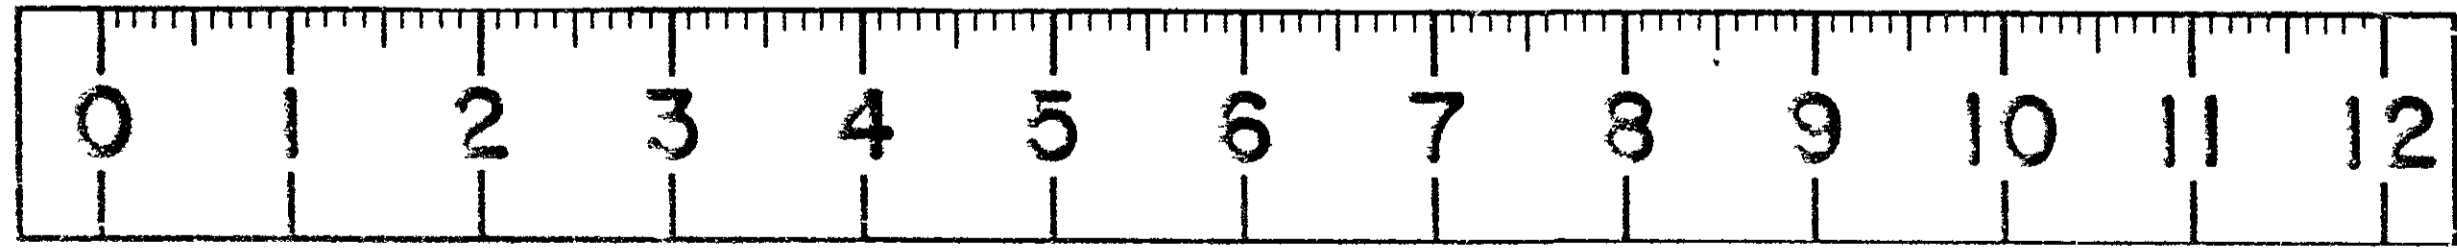


SURVEY FOR FRANK McCULLOUGH  
 S1 SECTION 8 T22S R5W WM  
 LANE COUNTY ORE.  
 Feb 1955

COUNTY SURVEYOR'S OFFICE  
 Print No. 9713  
 Tract No. 9713  
 Date Feb 1955

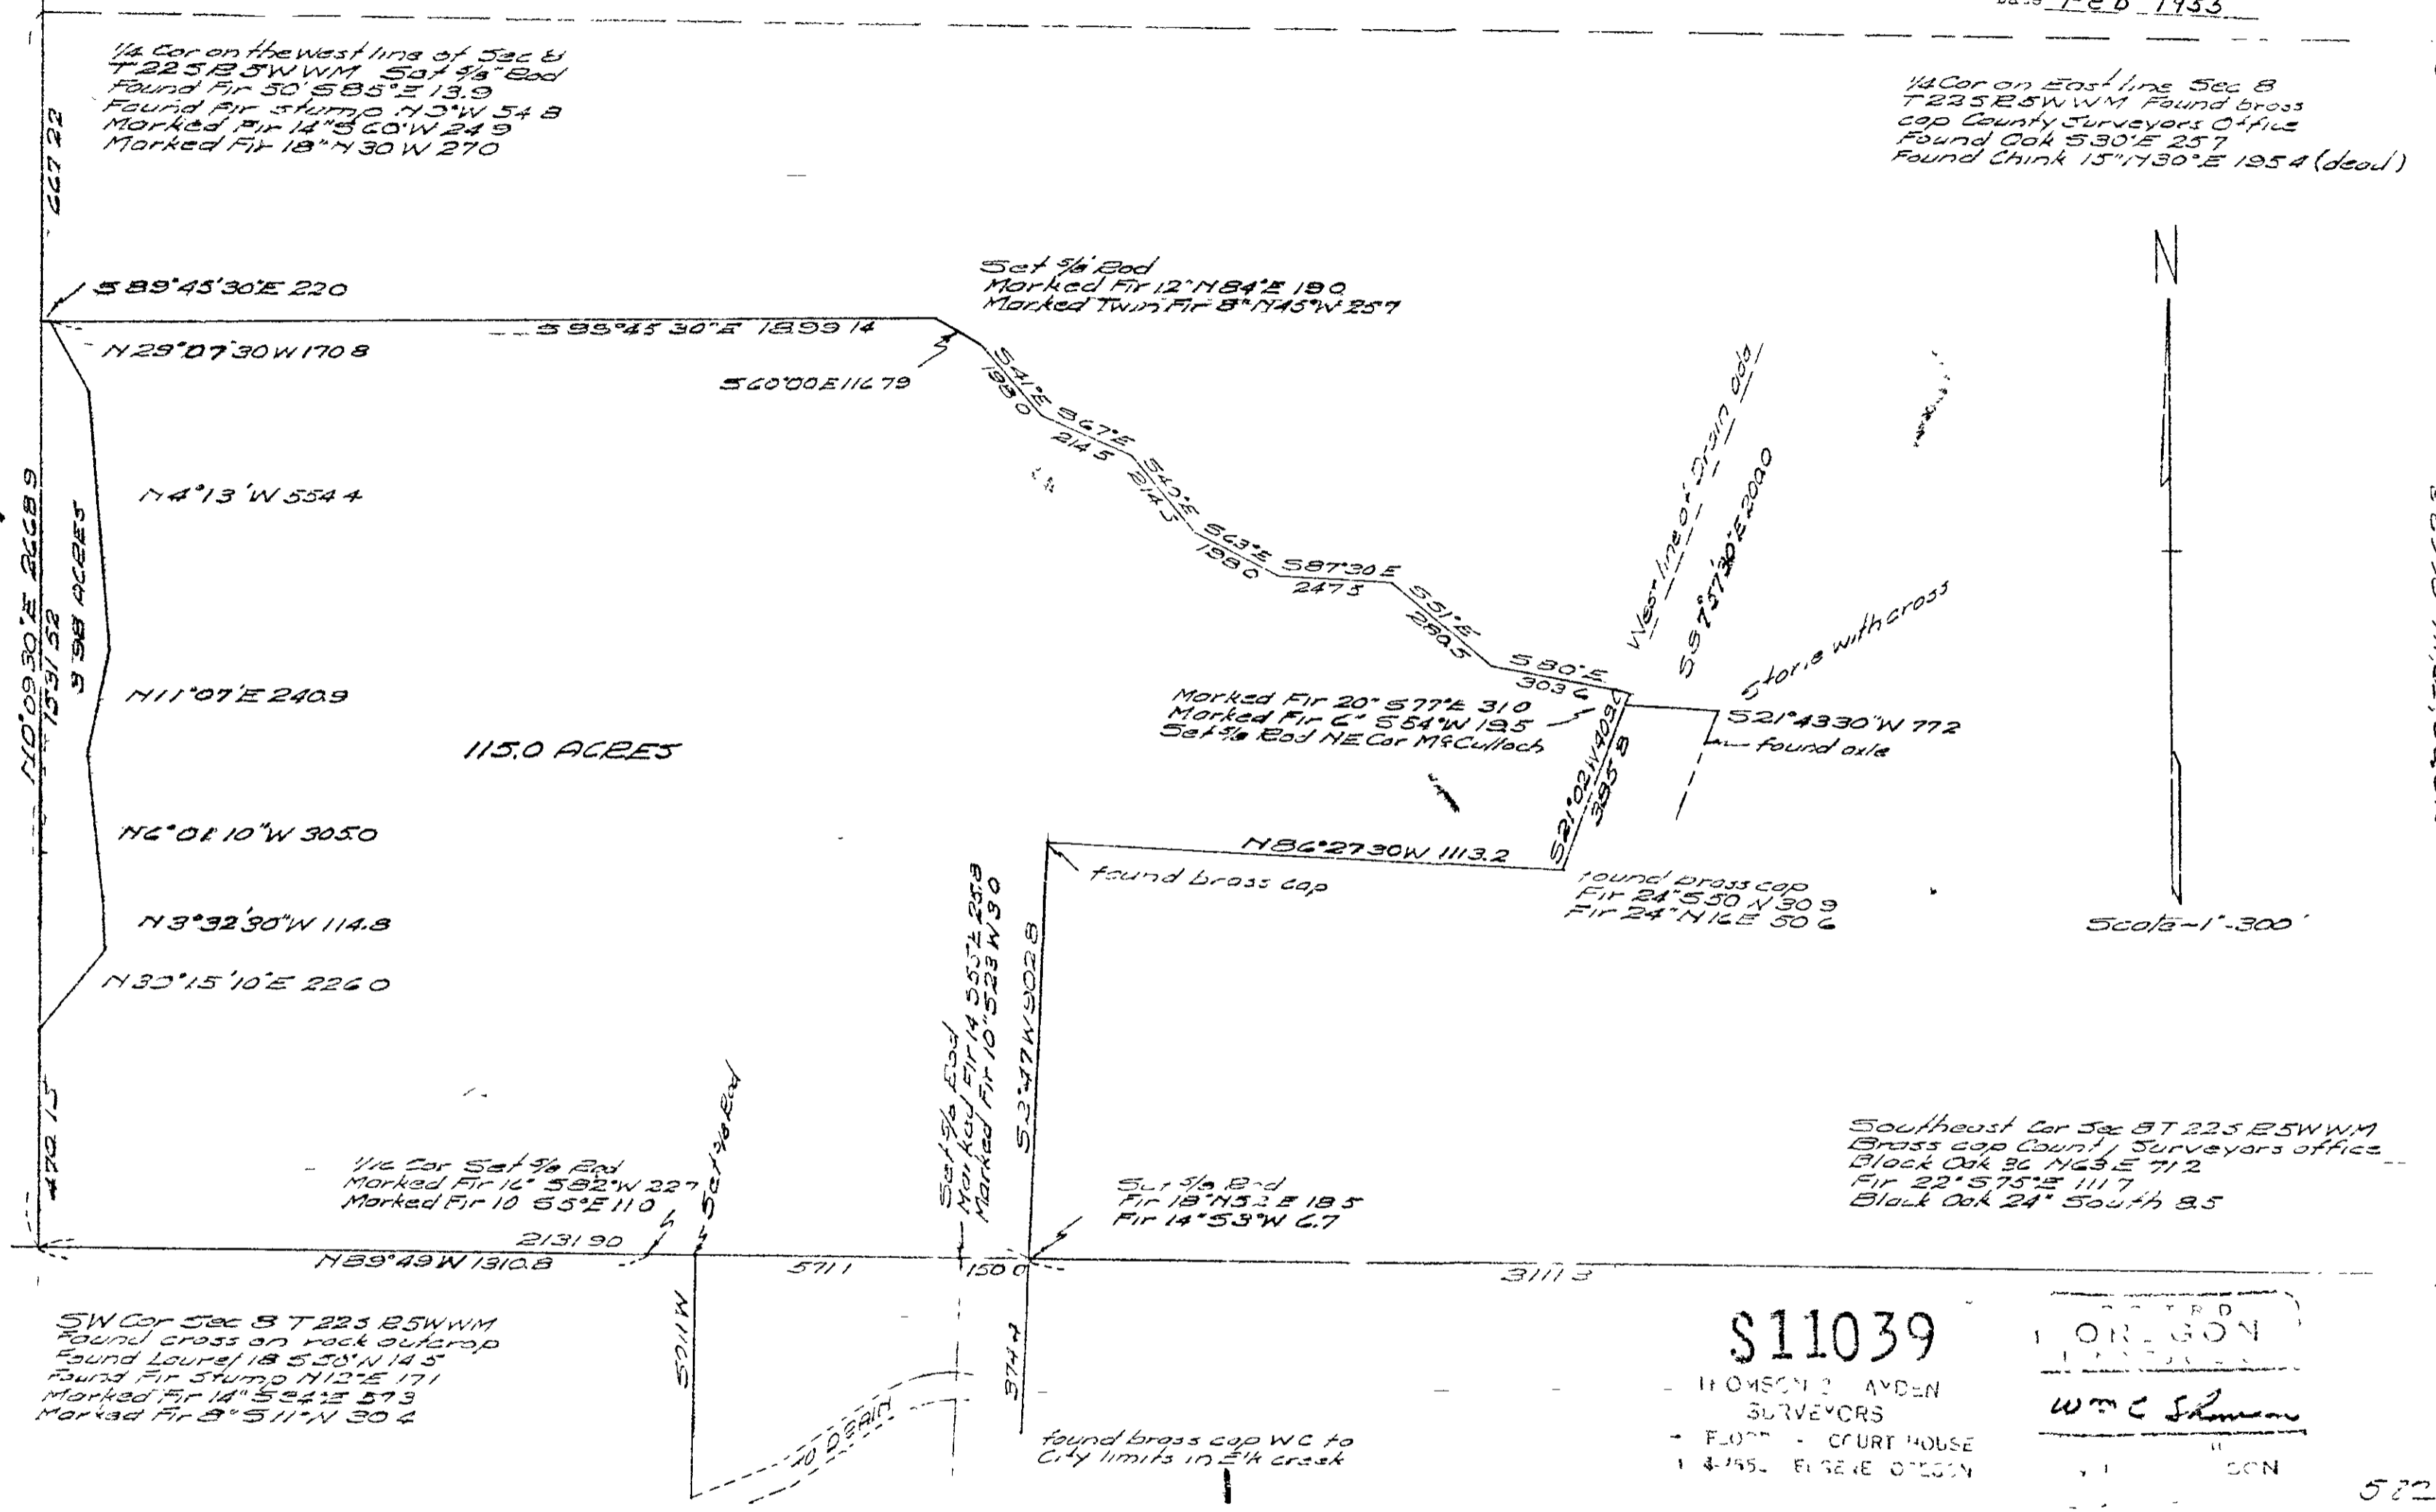

R = 11.5 01 27 75 0036 0482