


COUNTY SURVEYORS FILE DATA
DO NOT REMOVE FROM OFFICE

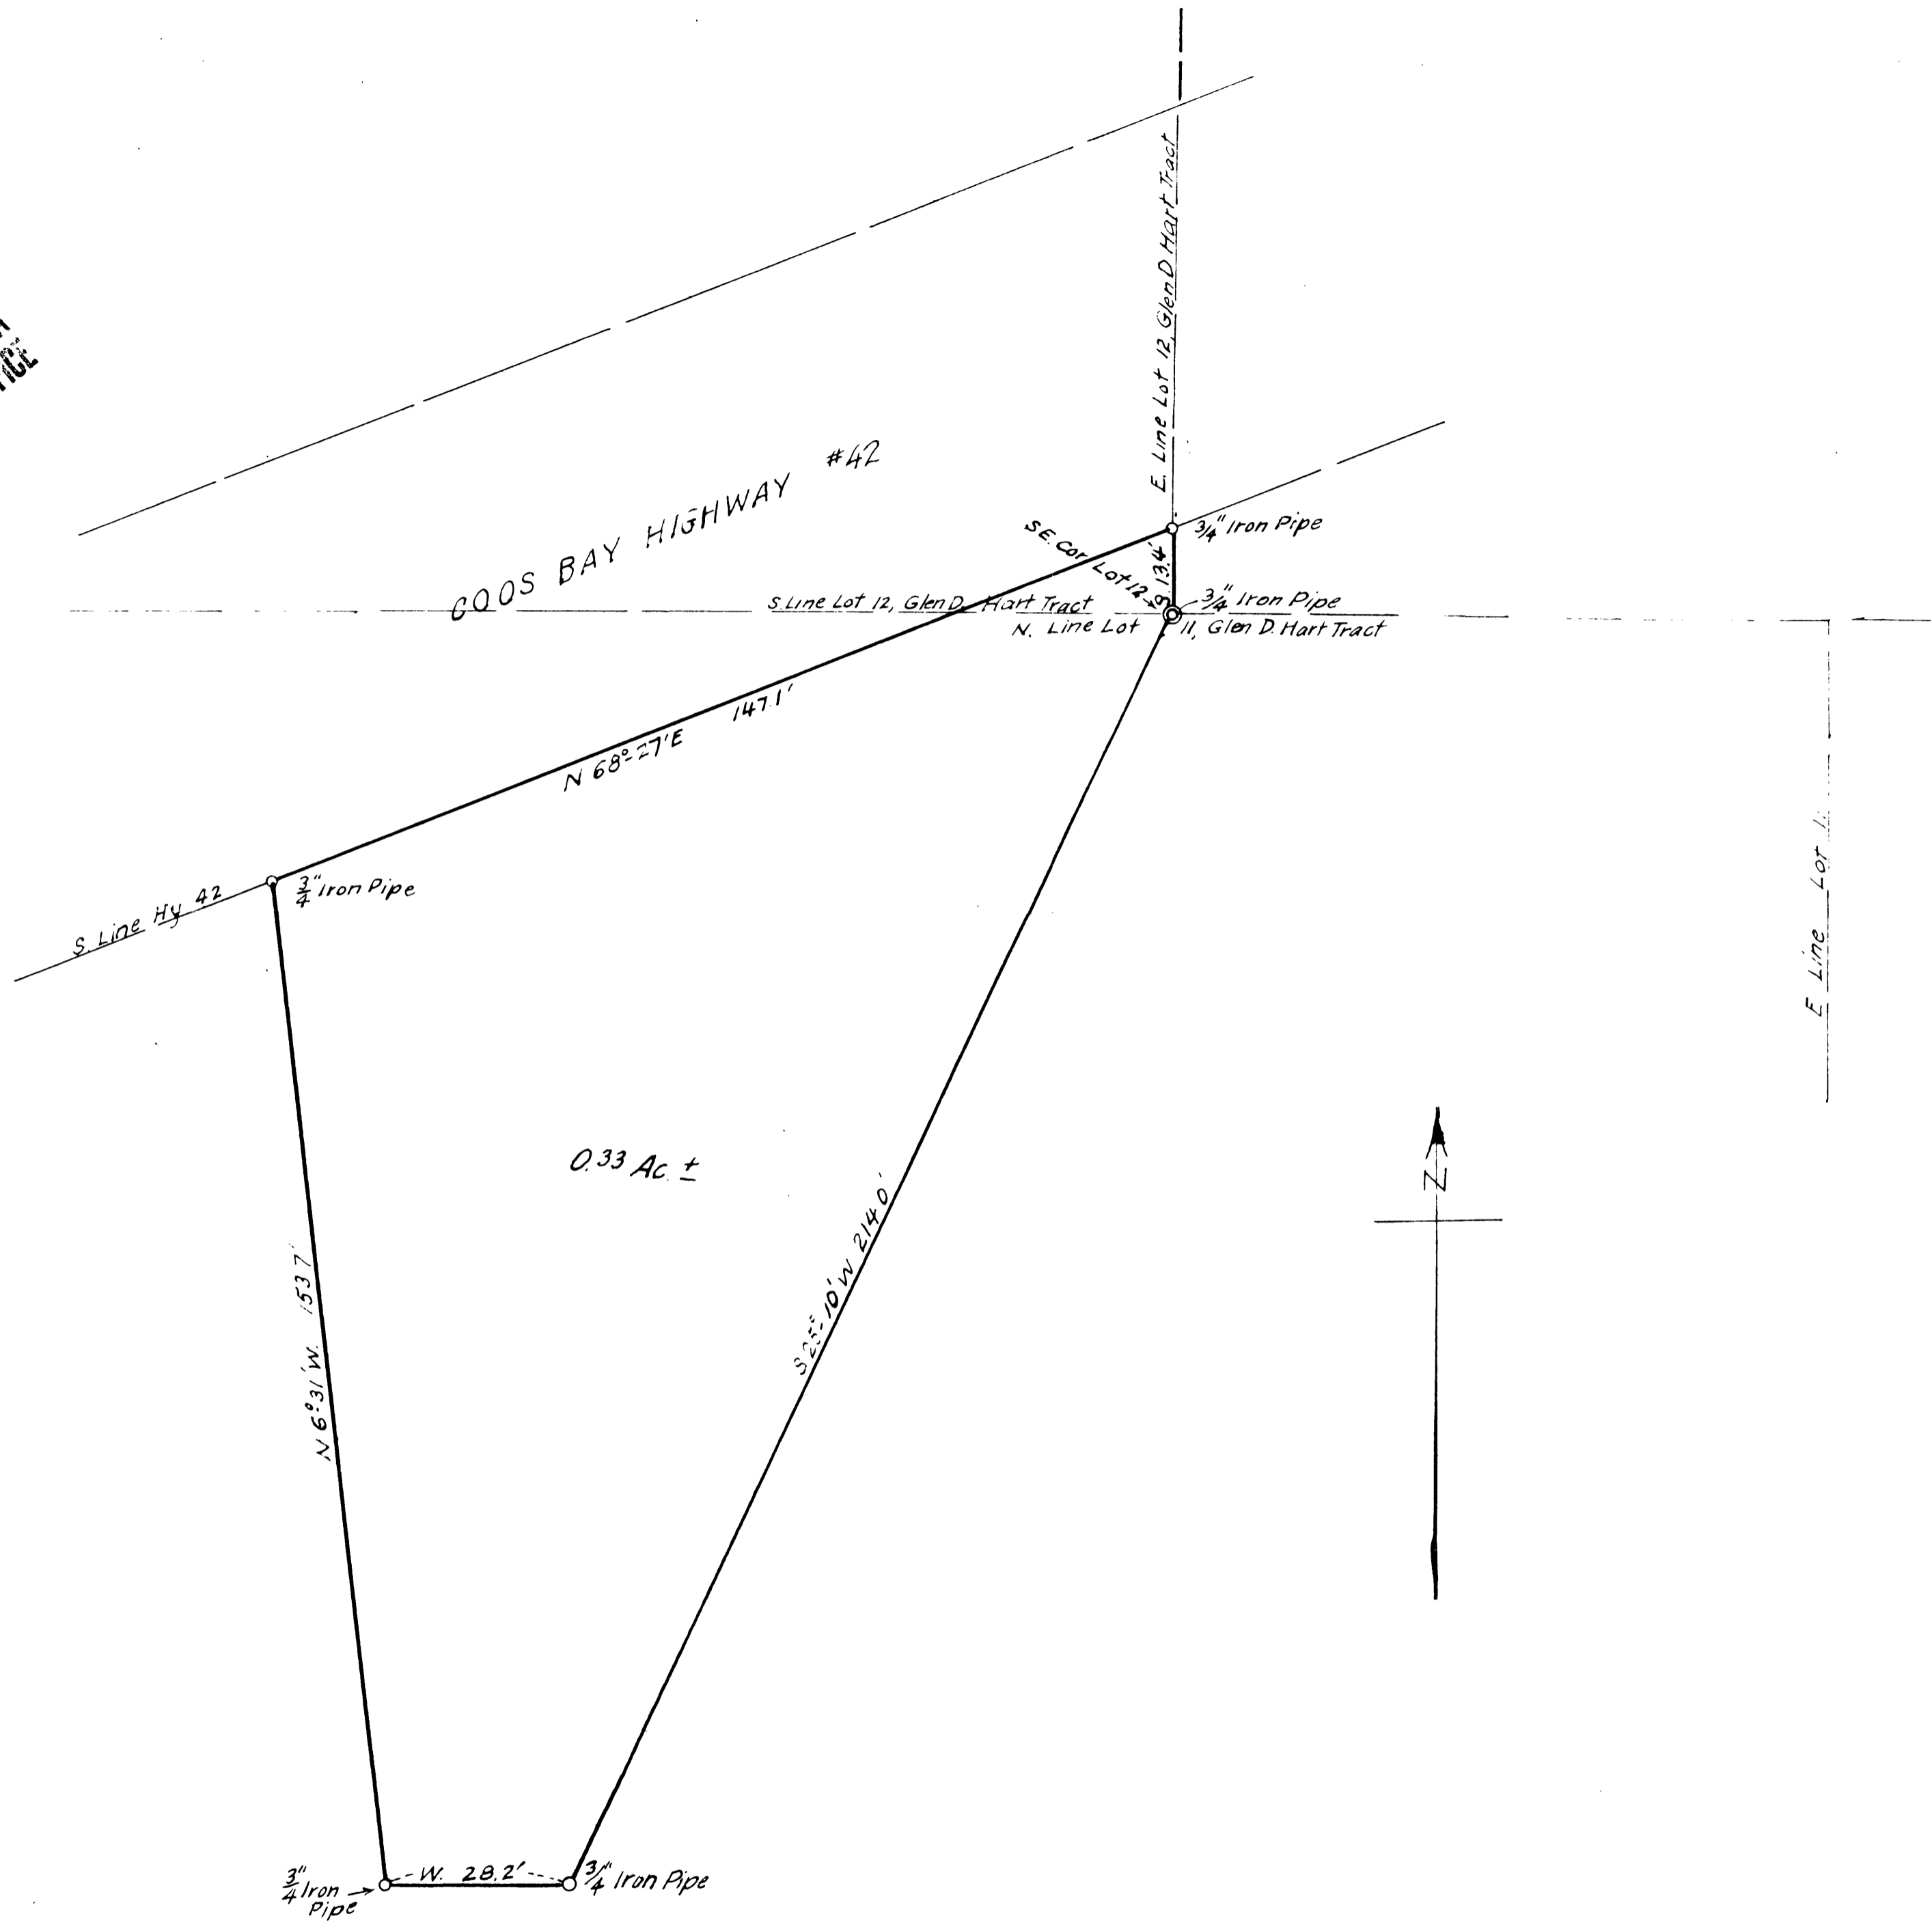

COUNTY SURVEYORS FILE DATA
DO NOT REMOVE FROM OFFICE

PORTION OF FRED BERKS PROPERTY,
ON COOS BAY HIGHWAY NO. 42,
ON WHICH RESIDENCE IS SITUATED
BEING IN LOT 11, GLEN D. HART TRACT
IN SEC. 21, T28S; R. 6W; W. M.
DEC. 1953 *ABryer* 1" = 20'

FILED
RECEIVED
MAR 24 1955
COUNTY SURVEYOR
DOUGLAS COUNTY, ORE.