

Mar. 21, 1955

S.W. Cor. Sec. 34 

33	34
4	3

  
T305, R6W W.M.

as det. by O.B.T.'s

A 30" B.O. Snag bears N11W 72.0'

A 25" B.O. Stump Hole bears N30E 84.5'

A 25" B.O. Stump bears S80E 69.0'

A 25" B.O. stump bears S32W 41.0'

At cor. pt. set 3/4" x 44" I.P.  
from which

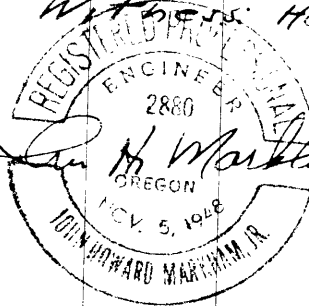
A 14" La. bears N74E 46.5'  
dist. mkd. 534 B.T.

A 15" La. bears N22E 17.0'  
dist. mkd. 534 B.T.

A 14" La. bears N35~~W~~ 29.0'  
dist. mkd. 533 B.T.

A fence corner bears S78W  
9.2' dist. fences run N-S-E-W-

Witness: Harry Dayton.

  
John H. Marham, Jr.

Work done for Harry Dayton.

C.S. File No. 41/370