
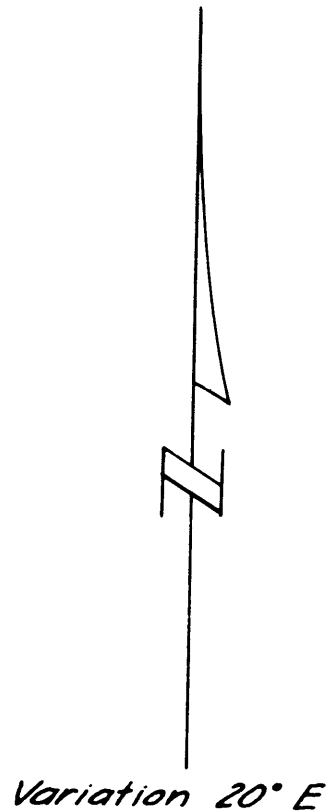


PROPERTY LINE SURVEY
 FOR
 J. H. & VELMA KLOPE
 SECTION 33, T. 30 S., R. 6 W., W.M.
 SCALE 1" = 200'

COUNTY SURVEYORS FILE DATA
 DO NOT REMOVE FROM OFFICE

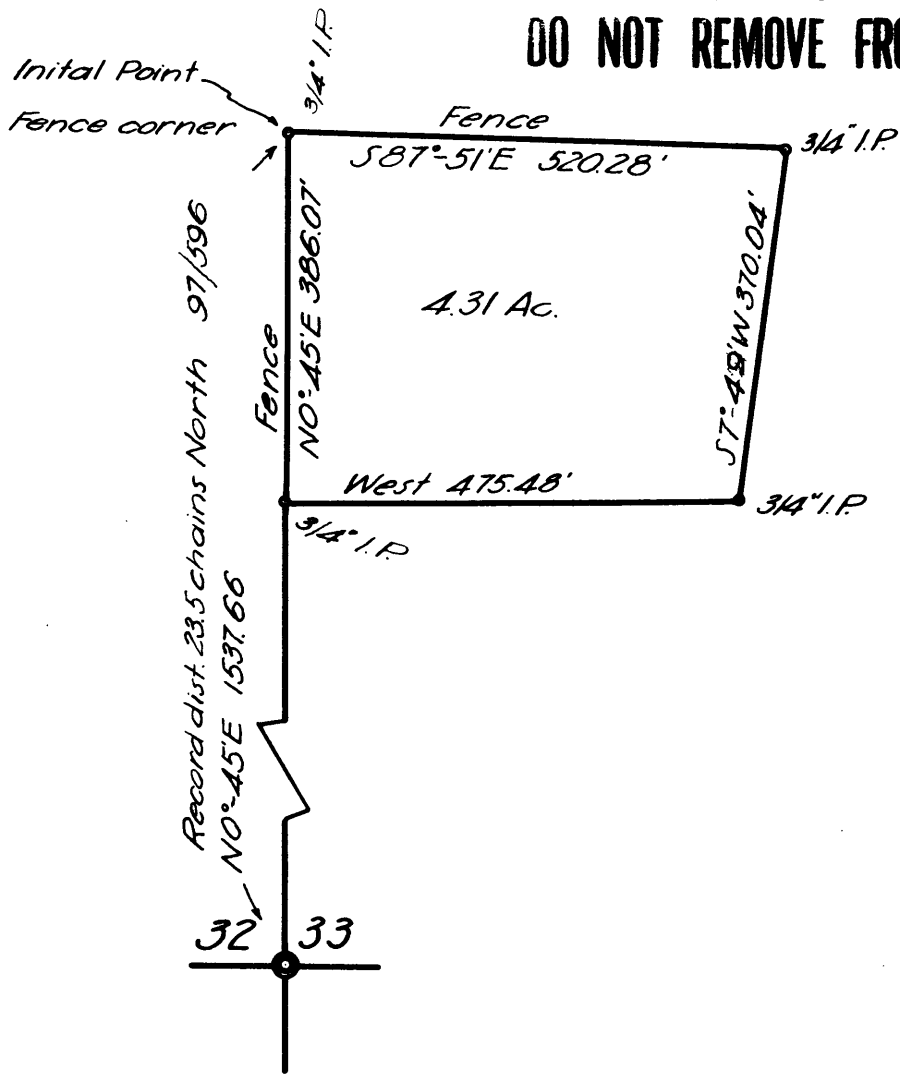

Section corner is iron pipe
 and brass set by Douglas Co.
 Surveyor March, 1954

I, R.H. Gee, do hereby certify that this survey was made
 by me for J. H. & Velma Klope in March, 1955 for sub-
 division of property.

R. H. Gee

Reg. Professional Engineer
 No. 3723

R. H. Gee

FILED
 RECEIVED

APR 28 1955

COUNTY SURVEYOR
 DOUGLAS COUNTY, ORE.

P. C. S. File No. 41/379