


REPORT ON

CORNERS OF THE CADASTRAL SURVEY GRID

T. 21 S. R. 8 W. , W. Mer., Oregon State.

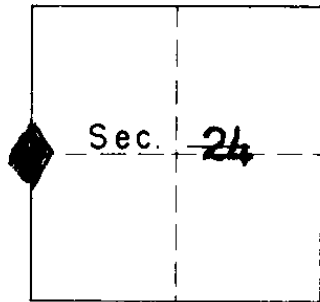

SYMBOLS



Official corner found.



Corner found, authenticity doubtful.



Corner searched for and not found.

DESCRIPTION OF CORNER MONUMENT.

$\frac{1}{4}$ Corner is a brass cap lettered - "U.S. General Land Office Survey - 1954." $\frac{1}{4}$ corner is in good condition.

DESCRIPTION OF BEARING TREES, MOUND OF STONE, ETC.

1. 36" Western red cedar stub 15' high N 50° E and approximately 10' from $\frac{1}{4}$ corner.

2. 32" Western red cedar snag. Due north and approximately 55' from $\frac{1}{4}$ corner.

DESCRIPTION OF LOCATION TO ENABLE RECOVERY BY OTHERS.

Corner is located 2 chains south and 2 chains east of junction of 3 creeks in a severely burned over area.

Reported By Wilson F. Edinger
Signature

Forester - B.L.M.

Title

June 1, 1955

Date

C. S. File No. 41/390

GPO 82-800094