


**PROPERTY LINE SURVEY
FOR
J.H. & VELMA KLOPE
SECTION 33, T.30S., R.6W., W.M.
1" = 100'**


FILED
RECEIVED

JAN 11 1956

COUNTY SURVEYOR
DOUGLAS COUNTY, ORE.

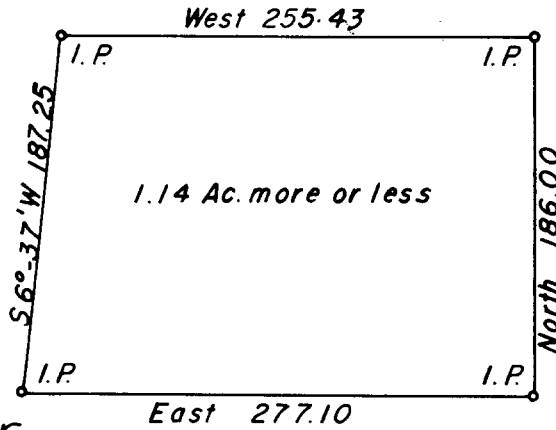

INITIAL POINT bears
1191.13 North and 522.20
East of the Southwest corner
Sec. 33, T.30 S., R. 6 W., W. M.

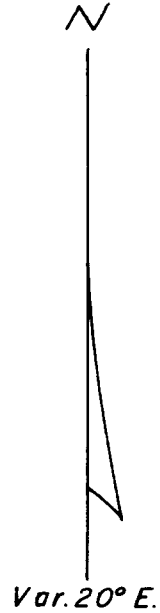

I, R. H. GEE, do hereby certify that this survey was made by me for J. H. and Velma Klope in August, 1955; for subdivision of property.

R. H. Gee

Registered Professional Engineer



**COUNTY SURVEYORS FILE DATA
DO NOT REMOVE FROM OFFICE**

P C. S. File No. 42/17-1