
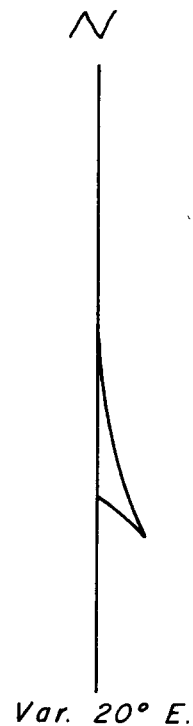


**PROPERTY LINE SURVEY
FOR
J. H. & VELMA KLOPE
SECTION 33 T. 30 S., R. 6 W., W. M.
SCALE 1" = 100'**

FILED
RECEIVED

JAN 11 1956

COUNTY SURVEYOR
DOUGLAS COUNTY, ORE.

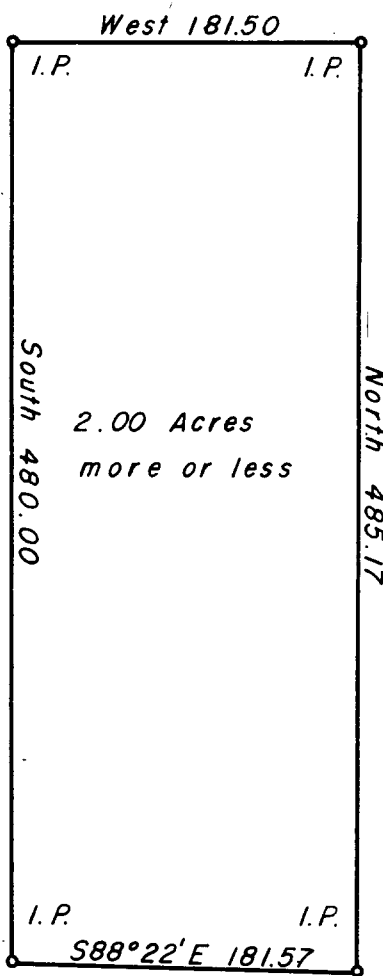

INITIAL POINT bears
S88°22'E 1047.03 feet
from the Southwest corner
Section 33, T. 30 S., R. 6 W., W. M.

I, R. H. GEE, do hereby certify that this survey was made by me for J. H. & Velma Klope in November, 1955, for subdivision of property.

R. H. Gee

R. H. Gee

**COUNTY SURVEYORS FILE DATA
DO NOT REMOVE FROM OFFICE**

C. S. File No. 42/17-5