

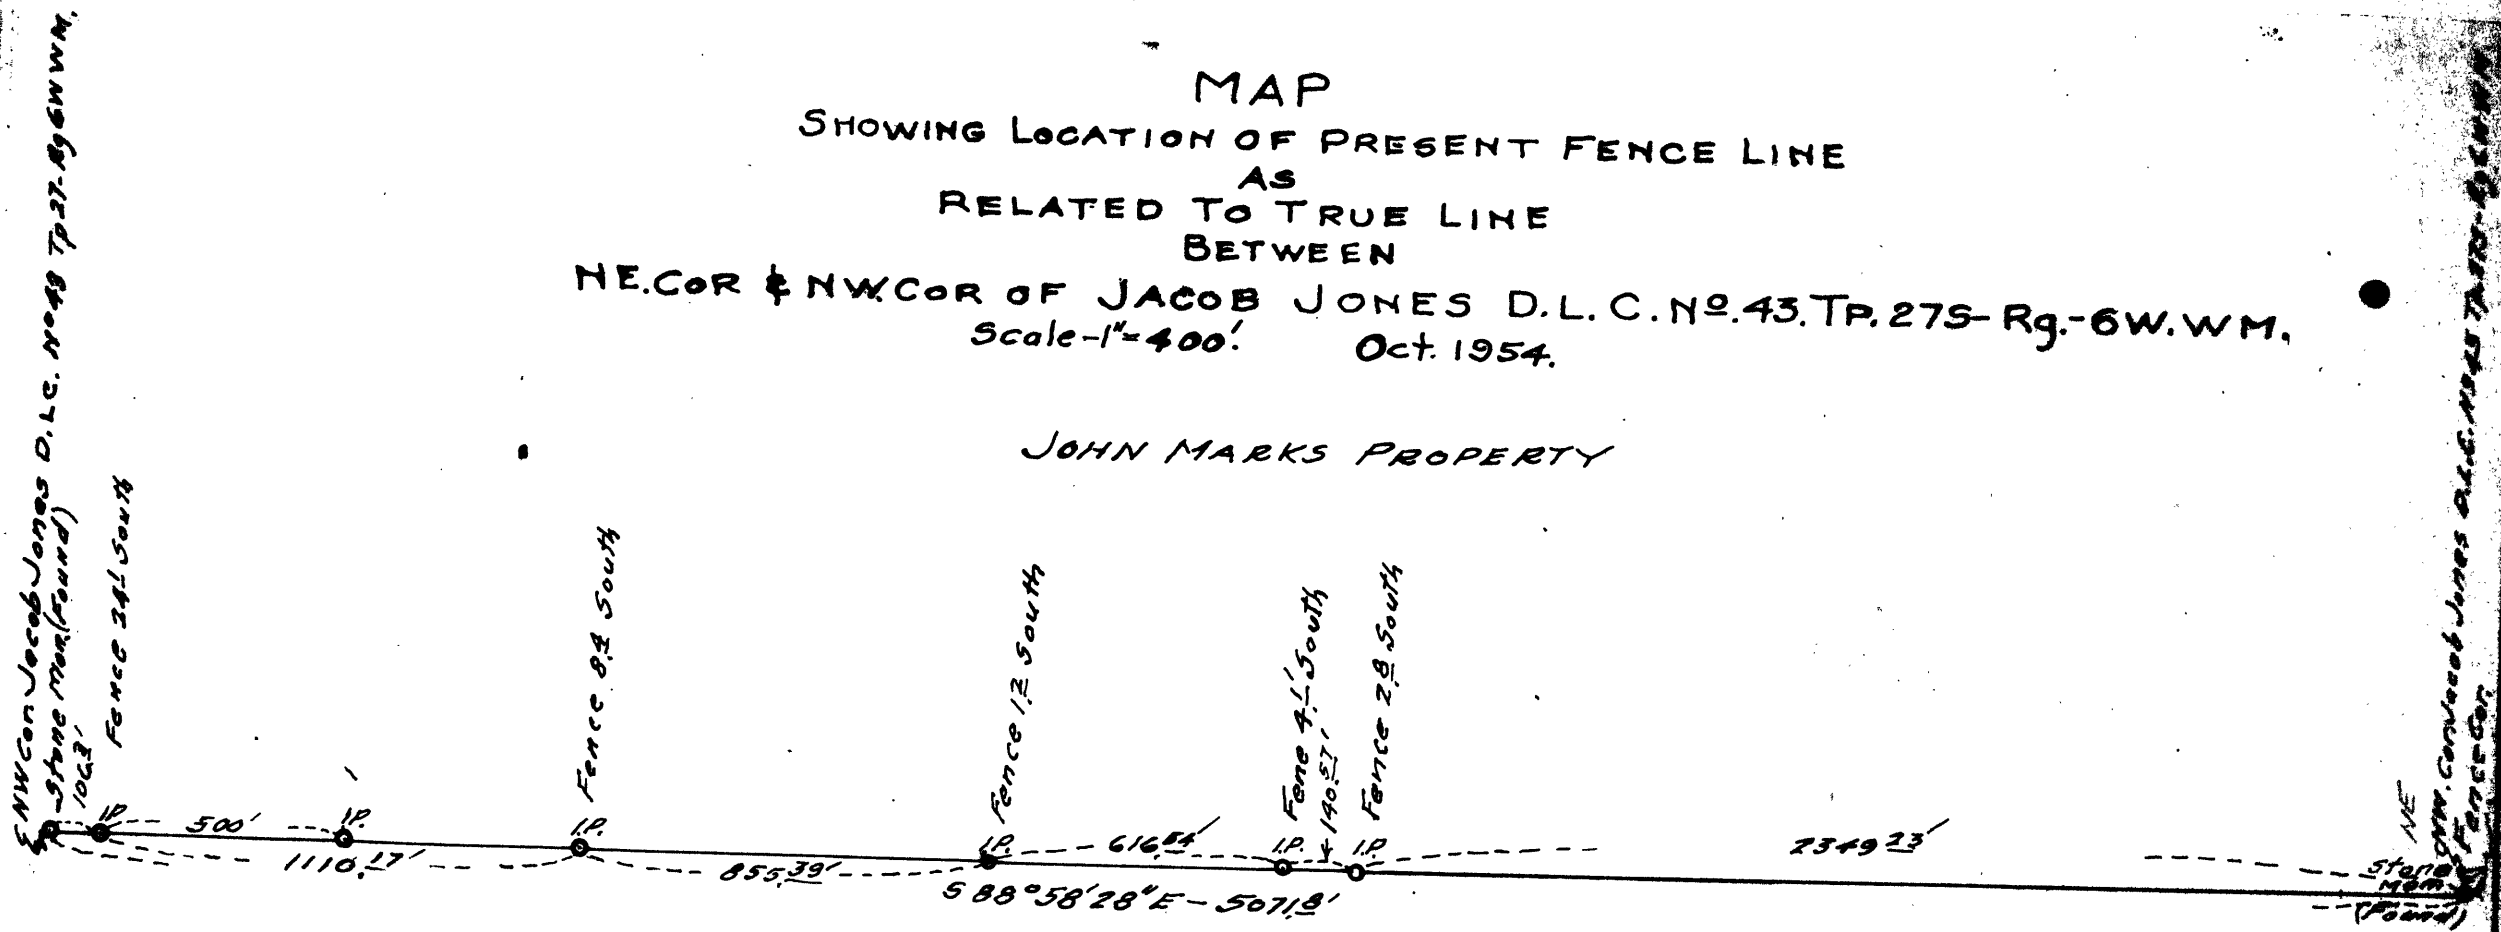


MAP
 SHOWING LOCATION OF PRESENT FENCE LINE
 AS
 RELATED TO TRUE LINE
 BETWEEN
 NE. COR & NW. COR OF JACOB JONES D.L.C. NO. 43, TP. 27S-Rg. 6W.WM.
 Scale - 1" = 400' Oct. 1954.

JOHN MARKS PROPERTY

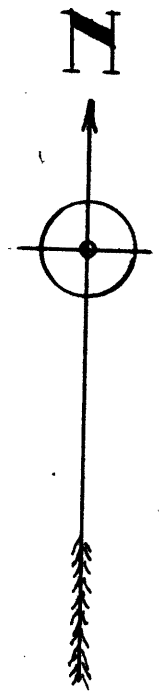

ED. MARKS PROPERTY

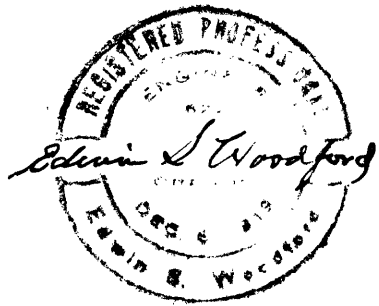

FILED
RECEIVED

JUL 1954

COUNTY SURVEYOR
DOUGLAS COUNTY, ORE.

COUNTY SURVEYORS FILE DATA
DO NOT REMOVE FROM OFFICE

c.s. 42/65-2

- 151 -

LINE BETWEEN ED MARKS & JOHN MARKS PROPERTY