


# PARCELS IN LOT 1-BLOCK 4-SHINN'S ADDITION

ROSEBURG-DOUGLAS COUNTY-OREGON

Surveyed for  
Mr. Gene Cooksey.

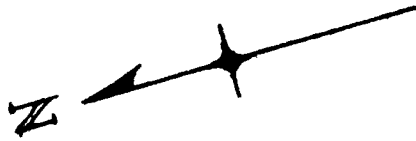

## LOT 1-BLOCK 4

LORRAINE AVE.

S 73°-30'E

1/2" Pipe Fd.

S 30°-21'W 400'

S 73°-30'E

100'

S 30°-21'W 300'

100'

1/2" I.P. Set

100'

1/2" I.P. Set

100'

1/2" I.P. Set

150'

150'

N 73°-30'W

LOOKINGGLASS-COUNTY ROAD 60'

N 30°-21'E

100'

1/2" I.P. Set

300'

100'

1 1/2" Pipe Fd.

FILED  
RECEIVED

JAN 16 1956

COUNTY SURVEYOR  
DOUGLAS COUNTY, ORE.

SURVEYED & PLATTED BY

SCALE 1" = 60'

JAMES R. DAUGHERTY

CIVIL-SANITARY ENGINEER  
ROSEBURG-ORE.

COUNTY SURVEYORS FILE DATA  
DO NOT REMOVE FROM OFFICE



JAN. 13, 1956.

SEC 22, T27S, R6W

C.S. File No. 42/86

①