


68/24 SD

COUNTY SURVEYORS FILE DATA
DO NOT REMOVE FROM OFFICE

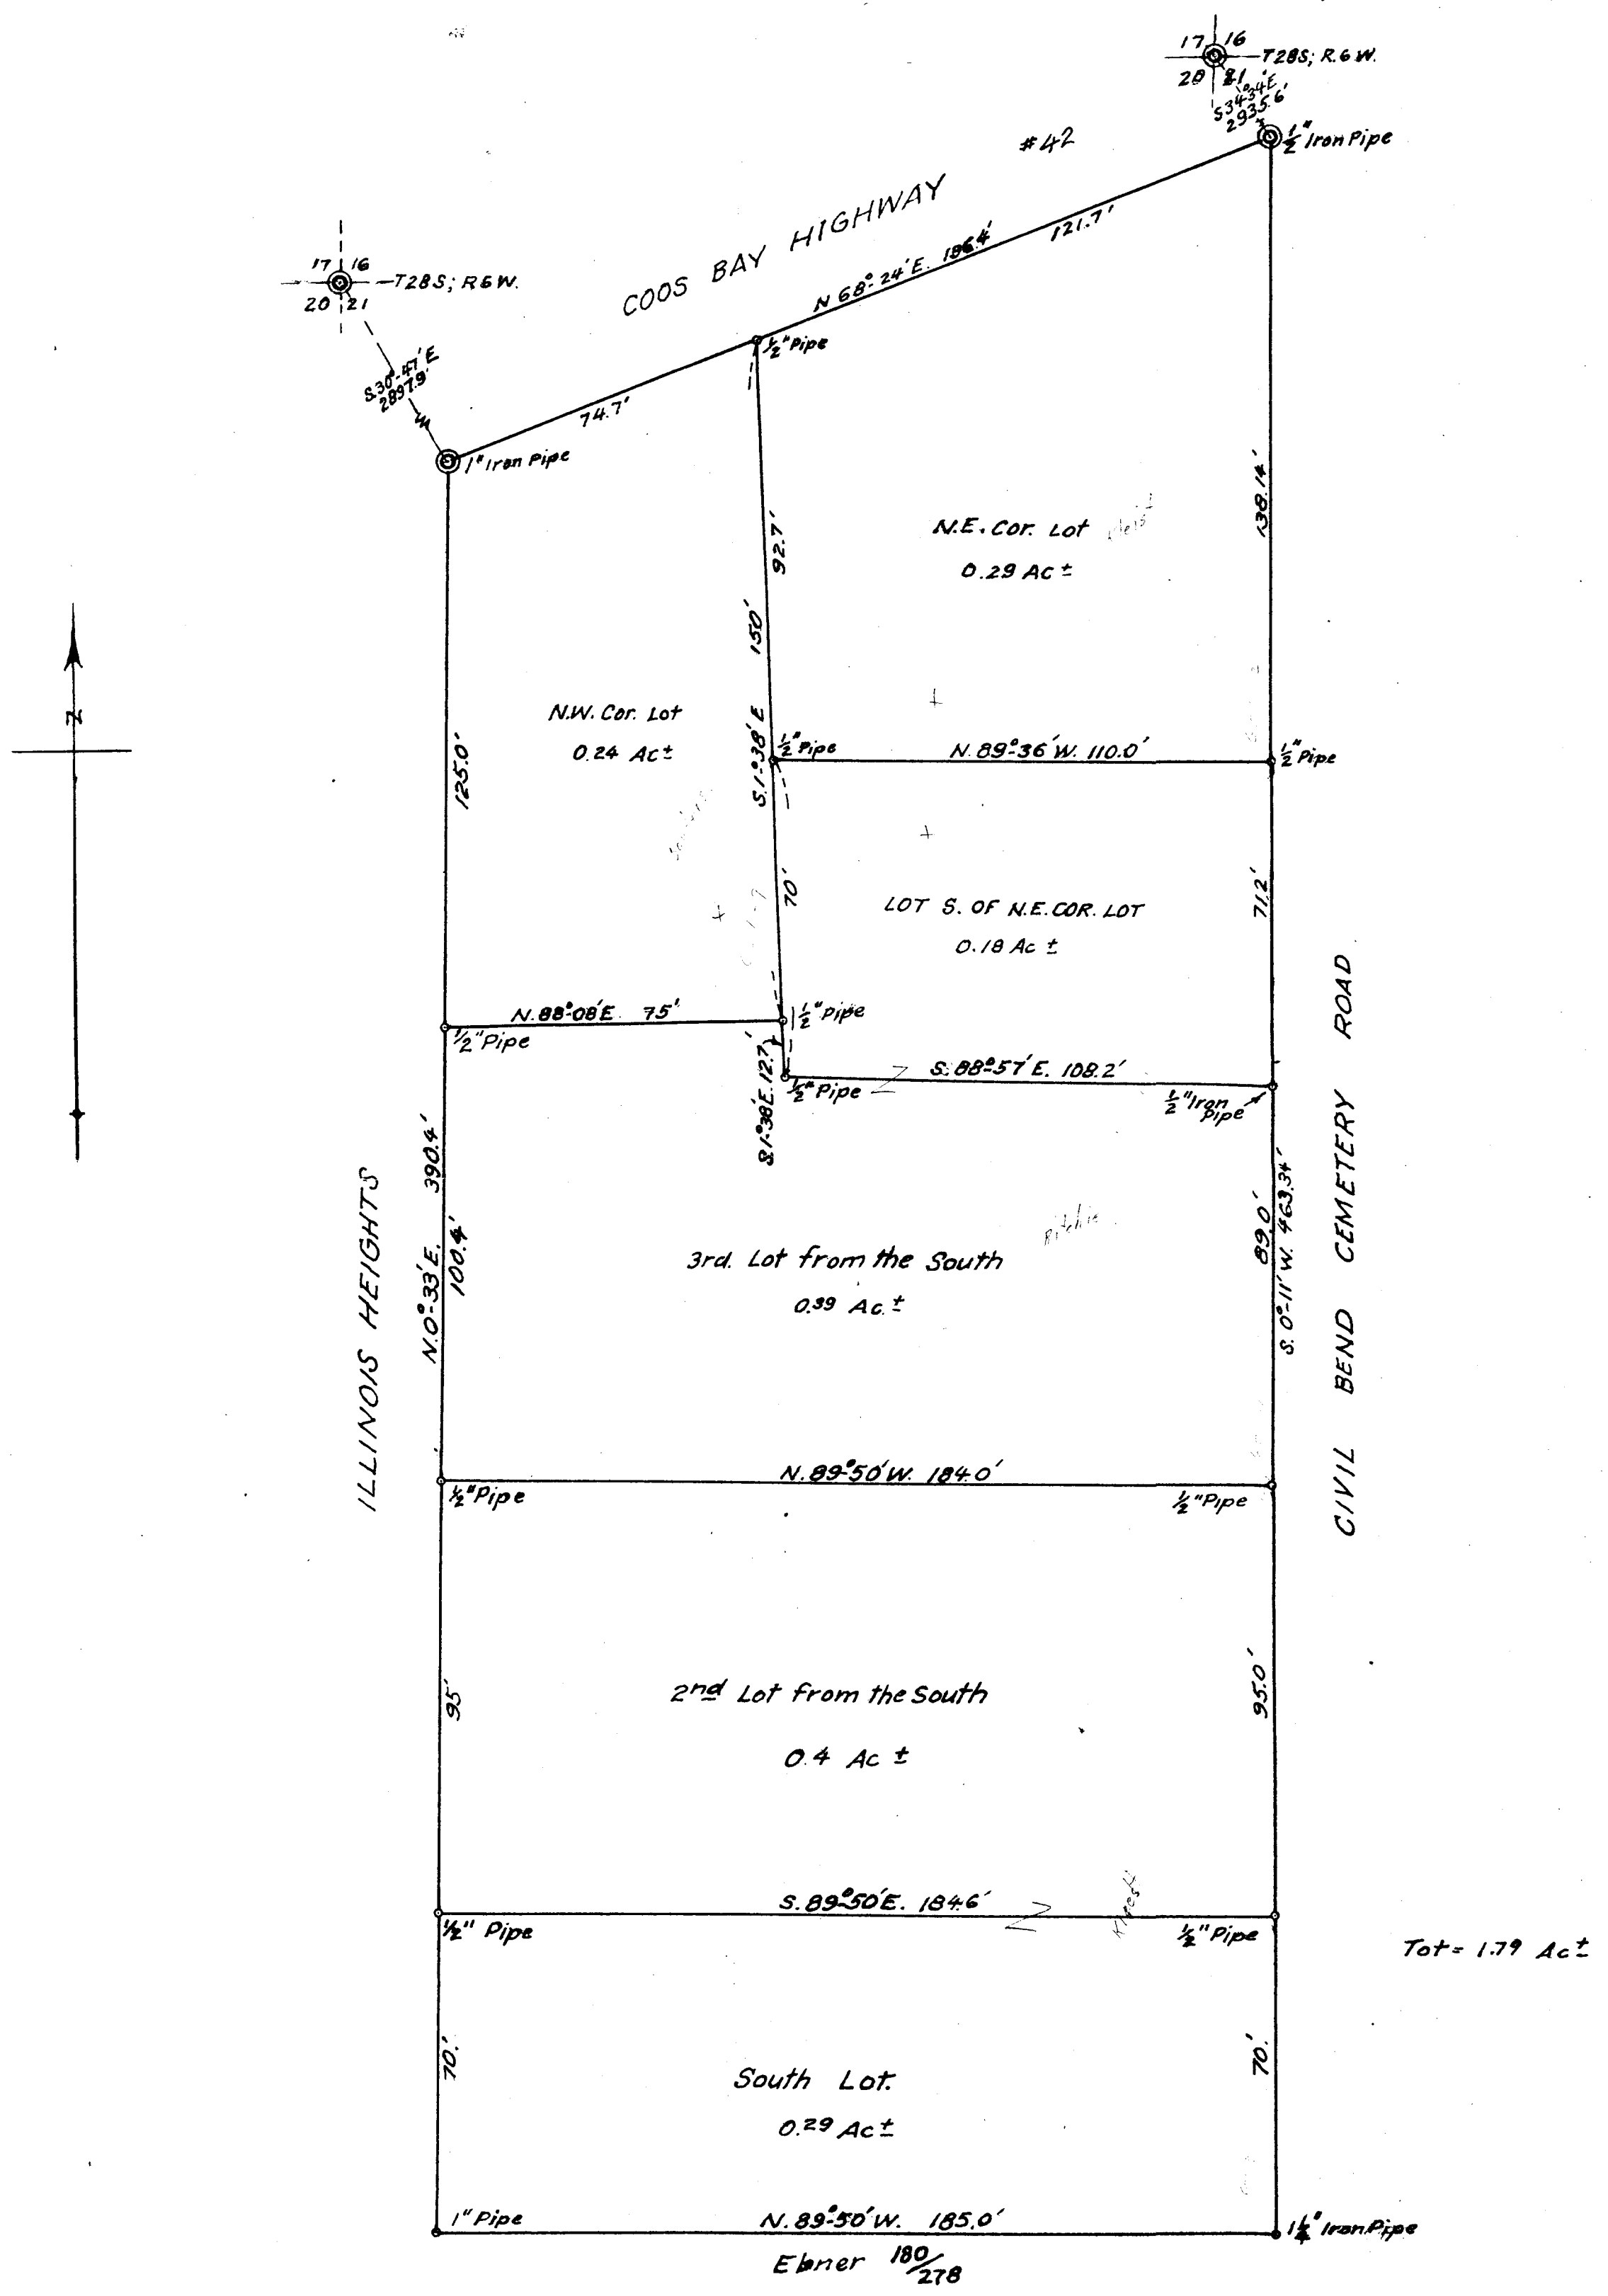

FILED
RECEIVED
JAN 16 1956
COUNTY SURVEYOR
DOUGLAS COUNTY, ORE.

MRS GRACE KLEIST,
WINSTON, ORE;
IN GLEN D. HART TRACT, LOTS 9 & 14.
IN SEC. 21, T28S; R6W; W.M.;
DOUGLAS COUNTY, ORE.
NOV. 1955 *A. Schindler* 1" = 30 ft.