


COUNTY SURVEYORS FILE DATA
DO NOT REMOVE FROM OFFICE

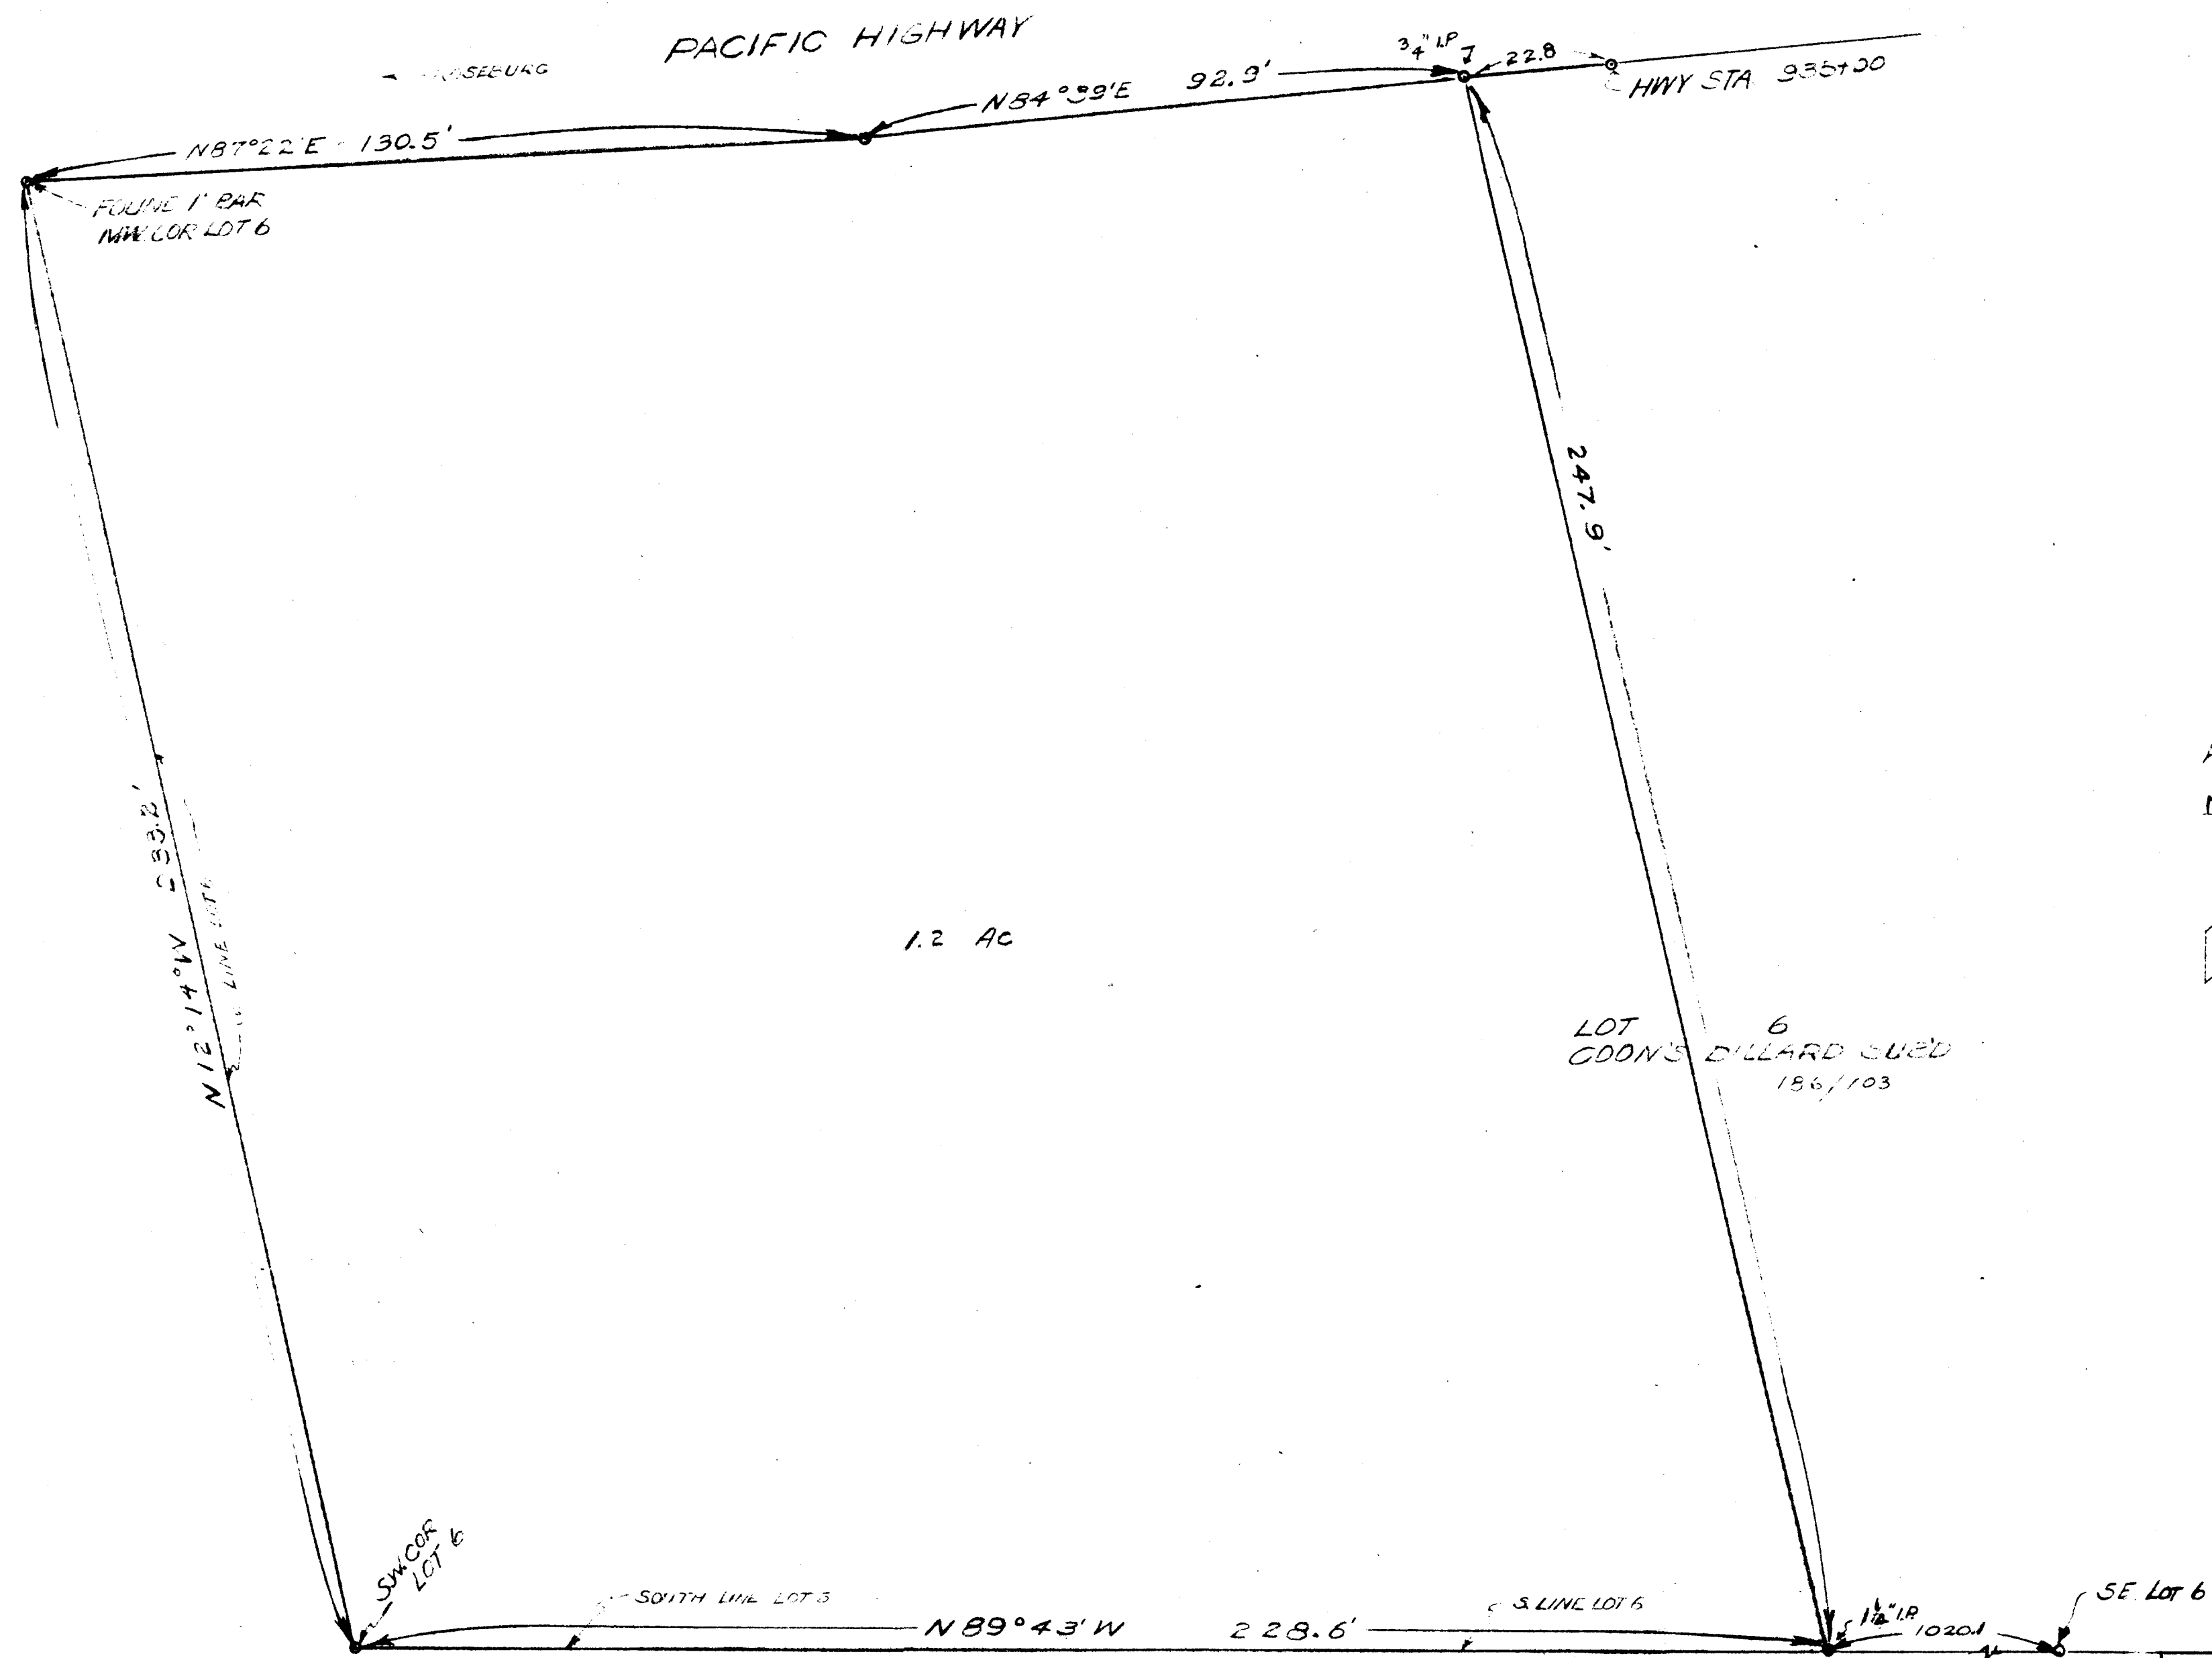

FILED
RECEIVED
JAN 16 1956
COUNTY SURVEYOR
DOUGLAS COUNTY, ORE.

MILES FEERO
1.2 ACRES ON WEST END OF
LOT 6 COON'S DILLARD SUB'D
IN SEC 2+3 T 29 S R 6 W W.M.
SCALE 1" = 20' Oct '55
A. BOYER