



Leake

FILED
RECEIVED

JAN 18 1956

COUNTY SURVEYOR
EQUIPULA COUNTY

MAP
SHOWING LAND SURVEYED
FOR
FRED LEAKE
IN
SECTION 34 TP.30S-RG.6 W.W.
SCALE - 1"=100' NOVEMBER - 1954.

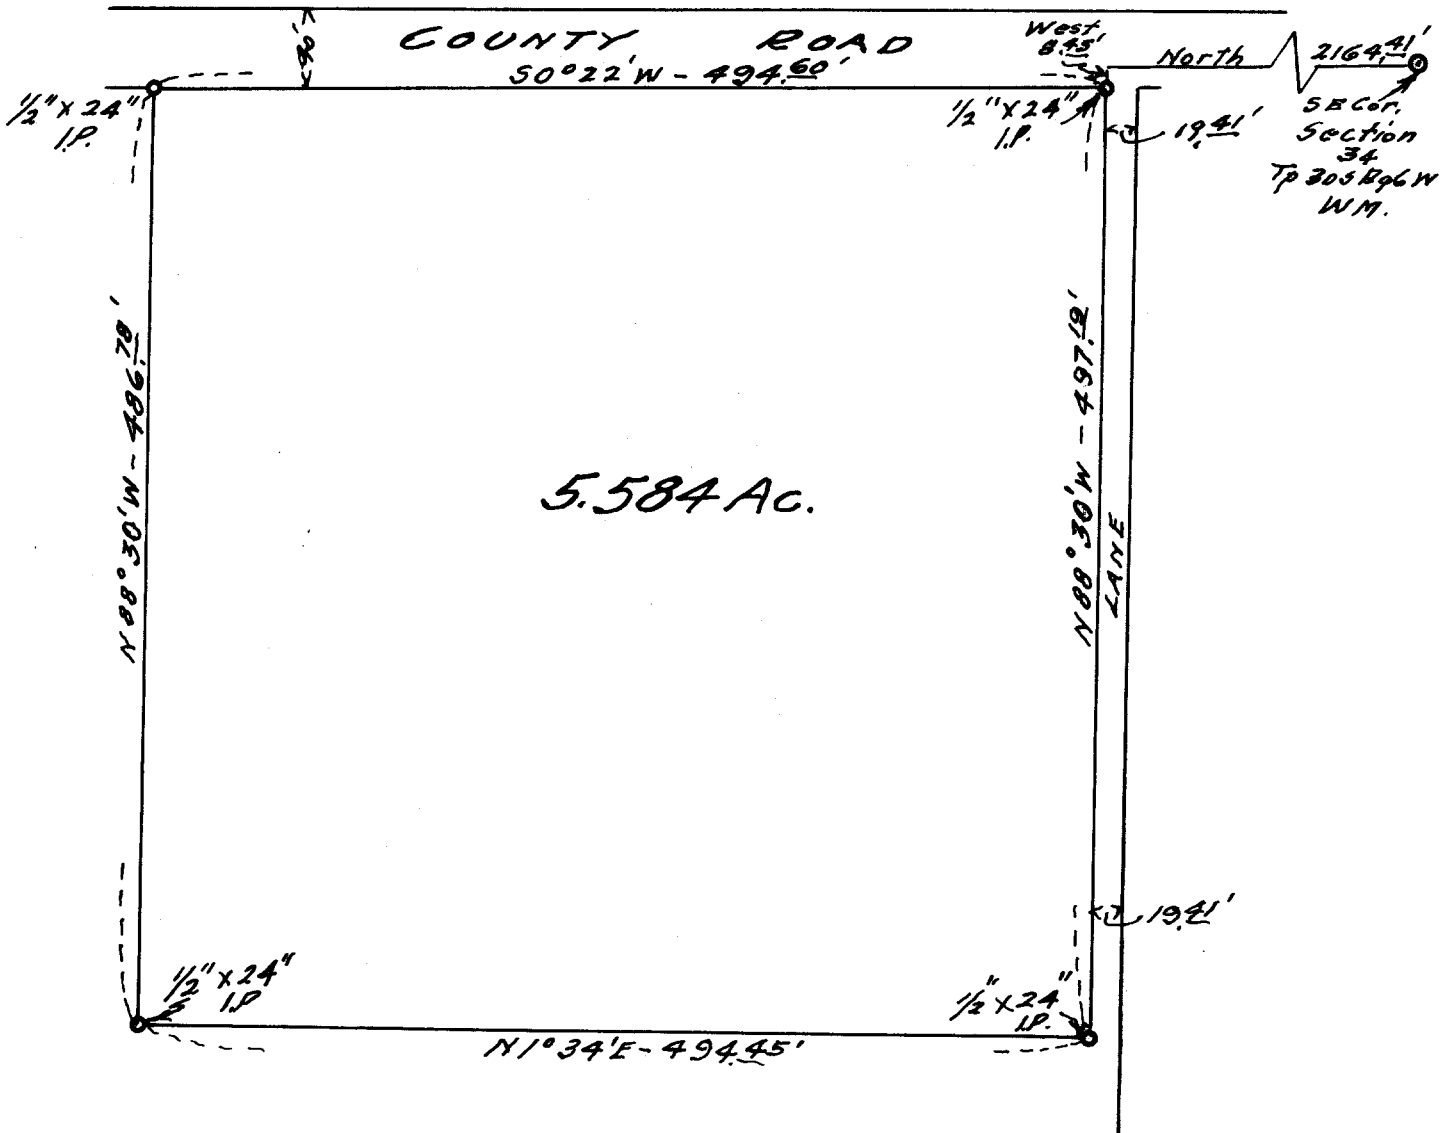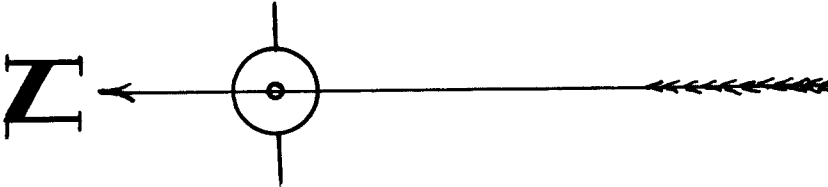

COUNTY SURVEYORS FILE DATA
DO NOT REMOVE FROM OFFICE

C.S. File No. 42/100

2

AMO

CS FILE FOLDER

CONTAINS

MORE

INFORMATION