


COUNTY SURVEYORS FILE BOOK
DO NOT REMOVE FROM OFFICE

S.W. Cor. Henry Evans
D.L.C. No. 43 Tp 26 S Rg 6 W
WN

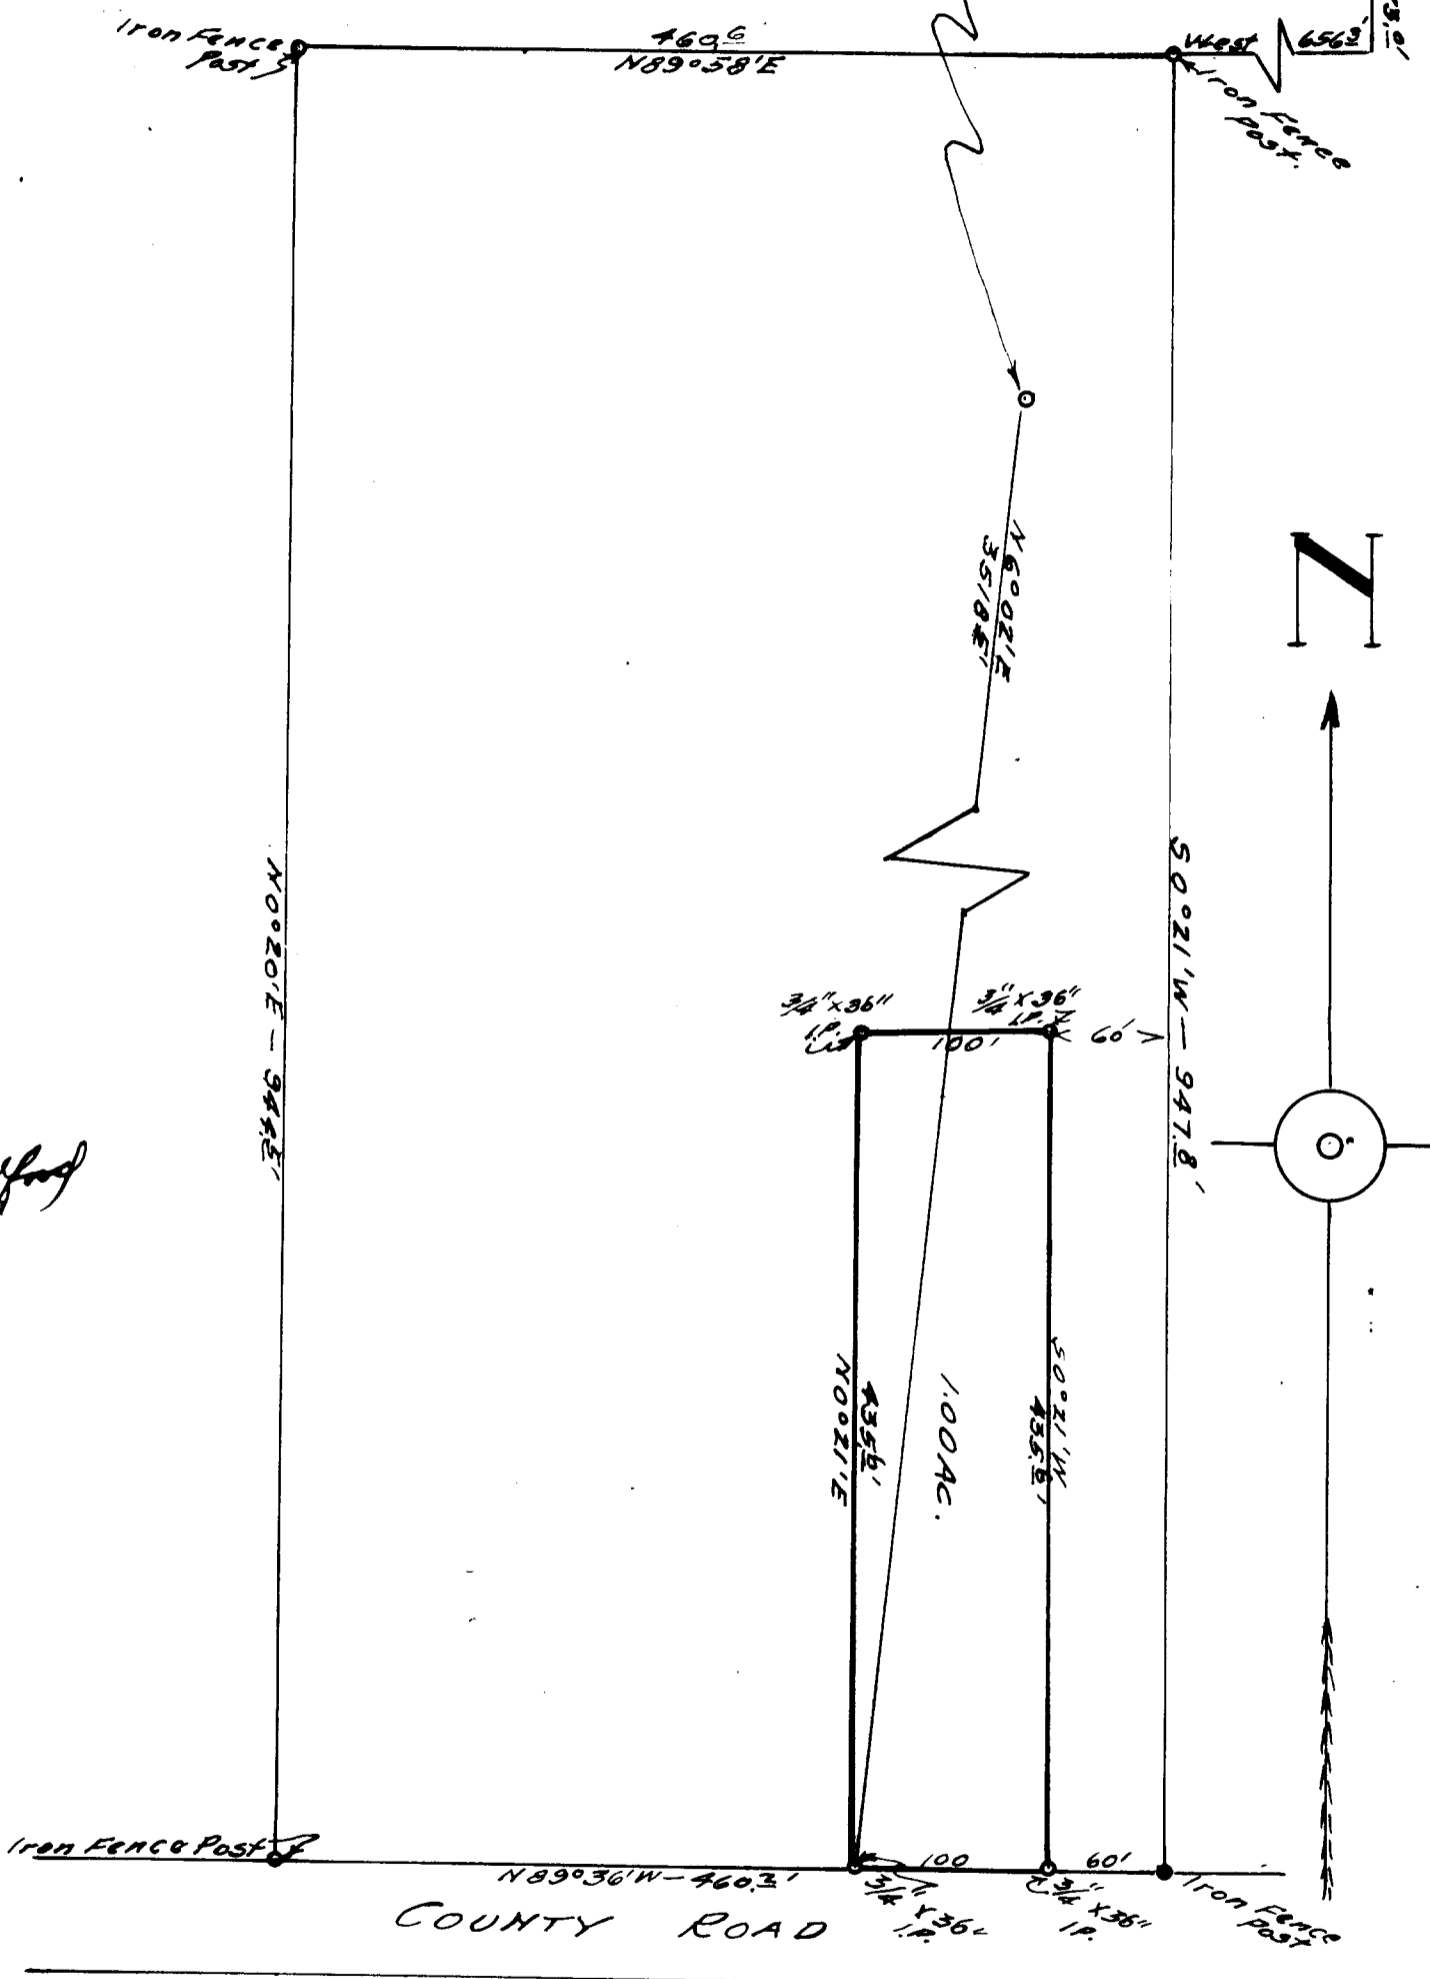

Edwin S Woodford

FILED
RECEIVED

JUN 18 1951

COUNTY SURVEYORS
DOUGLAS COUNTY

MAP
 SHOWING KIRK HARDICK PROPERTY
 IN
 Section 28 Tp 26 S - Rg 6 W W.M.
 Scale - 1" = 100'
 June 1951
 Edwin S Woodford Reg. Prof. Eng.

C.S. File No. 42/101

AWD

CS FILE FOLDER

CONTAINS

MORE

INFORMATION