

T 26 S R 5 W of W.M. COR. SECS.

21 | 22
28 | 27

FOUND 4 OLD B.T.s

14" Y. OAK N 22° E 39 LKS. - STANDING BUT DEAD

12" Y OAK S 71° E 57 LKS - DOWN

7" Y OAK N 26° W 80 LKS - FOUND STANDING

14" W OAK S 55° W 6 LKS - STANDING, BUT BADLY ROTTED.

SET 2" X 36" IRON PIPE FOR CORNER & MARK NEW TREES

24" W. OAK N 49° E 36.0 FT. SCRIBE S 22 T 26 S R 5 W 6 22 B.T.

7" W. OAK S 84° 30' E 39.6 FT. SCRIBE S 27 T 26 S R 5 W 6 22 B.T.


7" W. OAK S 76° 30' W 2.5 FT. SCRIBE S 28 T 26 S R 5 W 6 22 B.T.

8" W. OAK N 33° 45' W 32.0 FT. SCRIBE S 21 T 26 S R 5 W 6 22 B.T.

CORNER RENEWED IN AUGUST, 1952, ON JOB FOR WORTH
DAVIS (JOB IN FILE)

SET BY E. S. WOODFORD

WITNESS M. E. GODFREY

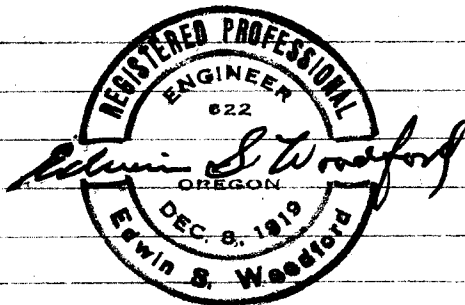

FILED
RECEIVED

JAN 17 1956

COUNTY SURVEYOR
DOUGLAS COUNTY, ORE.

C. S. File No. 42/114 - 2

AWD