

T 26 R 5 W OF W.M. 1/4 COR. SECS $\frac{22}{27}$

FOUND MOUND OF ROCK AND B.T. AS FOLLOWS

8" W. OAK S 18 3/4° E 234 LKS. - ORIGINAL B.T.

14" W. OAK N 48° W 387 LKS. - ORIGINAL B.T.

8" W. OAK S 80 1/2° W 11.0 FT. SCRIBED R.P. X

18" W. OAK N 31 1/4° E 24.5 FT. SCRIBED R.P. X


8" W. OAK S 5 1/4° E 24.5 FT. SCRIBED R.P. X

SET IN. AUG., 1952 ON JOB FOR WORTH DAVIS ← CHECK FILE
SET 1" X 30" IRON PIPE IN ROCK MOUND (2 2101) J03

PIPE SET BY E. S. WOODFORD

WITNESS M. E. GODFREY

AUGUST, 1952.

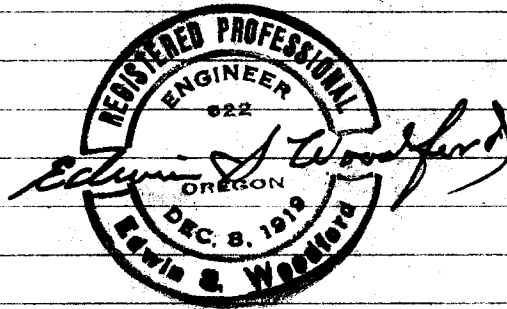

FILED
RECEIVED

JAN 10 1956

COUNTY SURVEYOR
DOUGLAS COUNTY, ORE

C.S. File No. 42/114-3