

GOVERNMENT CORNERS RENEWED

MOST NORTHERLY N.E. COR. D.L.C. #41, T28S R5W
FOUND BOTH B.T. SET BY CHARLIE ROBERTS ~~FOUND~~ IN
GOOD CONDITION.

STUB OF 1 ORIGINAL B.T. FOUND BUT TOO BADLY ROTTED
AND BURNED OUT - NO SCRIBE MARKS.

IRON ROD SET BY ROBERTS NOT FOUND.

SET 1/2" X 48" IRON PIPE FOR CORNER.

DID NOT MARK ANY NEW B.T.s, SINCE TREES MARKED
BY ROBERTS WERE STILL GOOD.


SET ON T. E. DUNCAN JOB - NOV. 1955 (Job in file)

SET BY E. S. WOODFORD

WITNESS M. F. GODFREY

~~1/4 SEC. COR. BETWEEN SECS 7 & 8, T27S R5W~~

~~FOUND BLACK OAK BT.~~

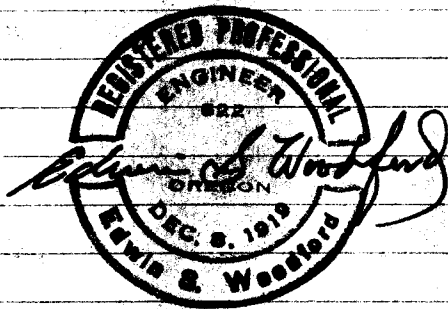

FILED
RECEIVED

JAN 19 1956

COUNTY SURVEYOR
DOUGLAS COUNTY, ORE

C. S. File No. 42/115

[Handwritten initials]

CS FILE FOLDER

CONTAINS

MORE

INFORMATION