

T 25 S R 7 W

1/4 COR. SECs.

33*34

SET STEEL AXLE WITH GEAR ATTACHED FOR CORNER FROM
STUMP OF OLD B.T. FOUND

W. OAK, N 1/4° E 432 LKS. FOUND REVERSE OF SCRIBE
MARKS INSIDE HOLLOW OF STUMP

MKD. 2 NEW B.Ts.

20" B. OAK N 20° W 58.55 FT.

12" B. OAK N 24° W 66.22 FT.


BOTH NEW TREES ARE IN SAME QUADRANT, BUT NO TREES
AVAILABLE IN ANY OTHER QUADRANTS.

CORNER RENEWED IN AUGUST, 1949, ON JOB FOR
O.C. THOMPSON

SEPARATE

SET BY E. S. WOODFORD

WITNESS ART NELSON

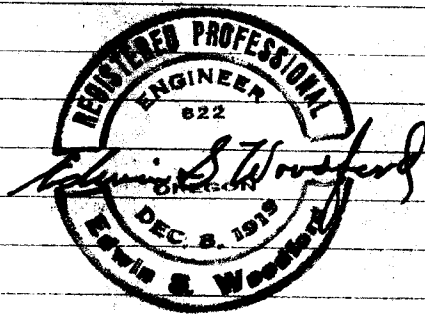

FILED
RECEIVED

JAN 19 1956

COUNTY SURVEYOR
DOUGLAS COUNTY, ORE

C. S. File No. 42/118