

ON TOWNSHIP LINE T 25 S R 7 W
T 26 S R 7 W

COR. SECS.

R 7 W	
33	34 T 25 S
4	3 T 26 S

1" X 30" STEEL SHAFI SET FOR CORNER. FROM 1 OLD BT FOUND
24" OAK S 75° E 43 LKS - (TREE NOW 36")
FOUND REVERSE OF SCRIBE MARKS IN CUT OUT SLAB.

MKD. NEW TREE

15" FIR S 30 1/2° E 7.7 ft.


CORNER RENEWED IN AUGUST, 1946, ON JOB FOR BRUCE
YEAGER.

SEPARATE

SET BY E. S. WOODFORD

WITNESSES

MARR
LINEHART

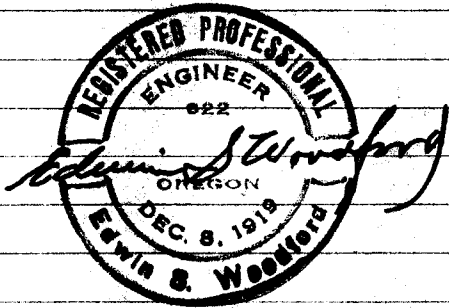

FILED
RECEIVED

JAN 19 1956

COUNTY SURVEYOR
DOUGLAS COUNTY, ORE.

[Handwritten signature]

C. S. File No. 42/119