

SURVEY for MARCHIOLI


IN

Section 34; Twp. 21 S.; R. 5 W. W. M.

Scale: 1" = 60.0'

February 1956

N.W. Cor. Elijah Estes
D.L.C. No. 37; T21S; R5W.

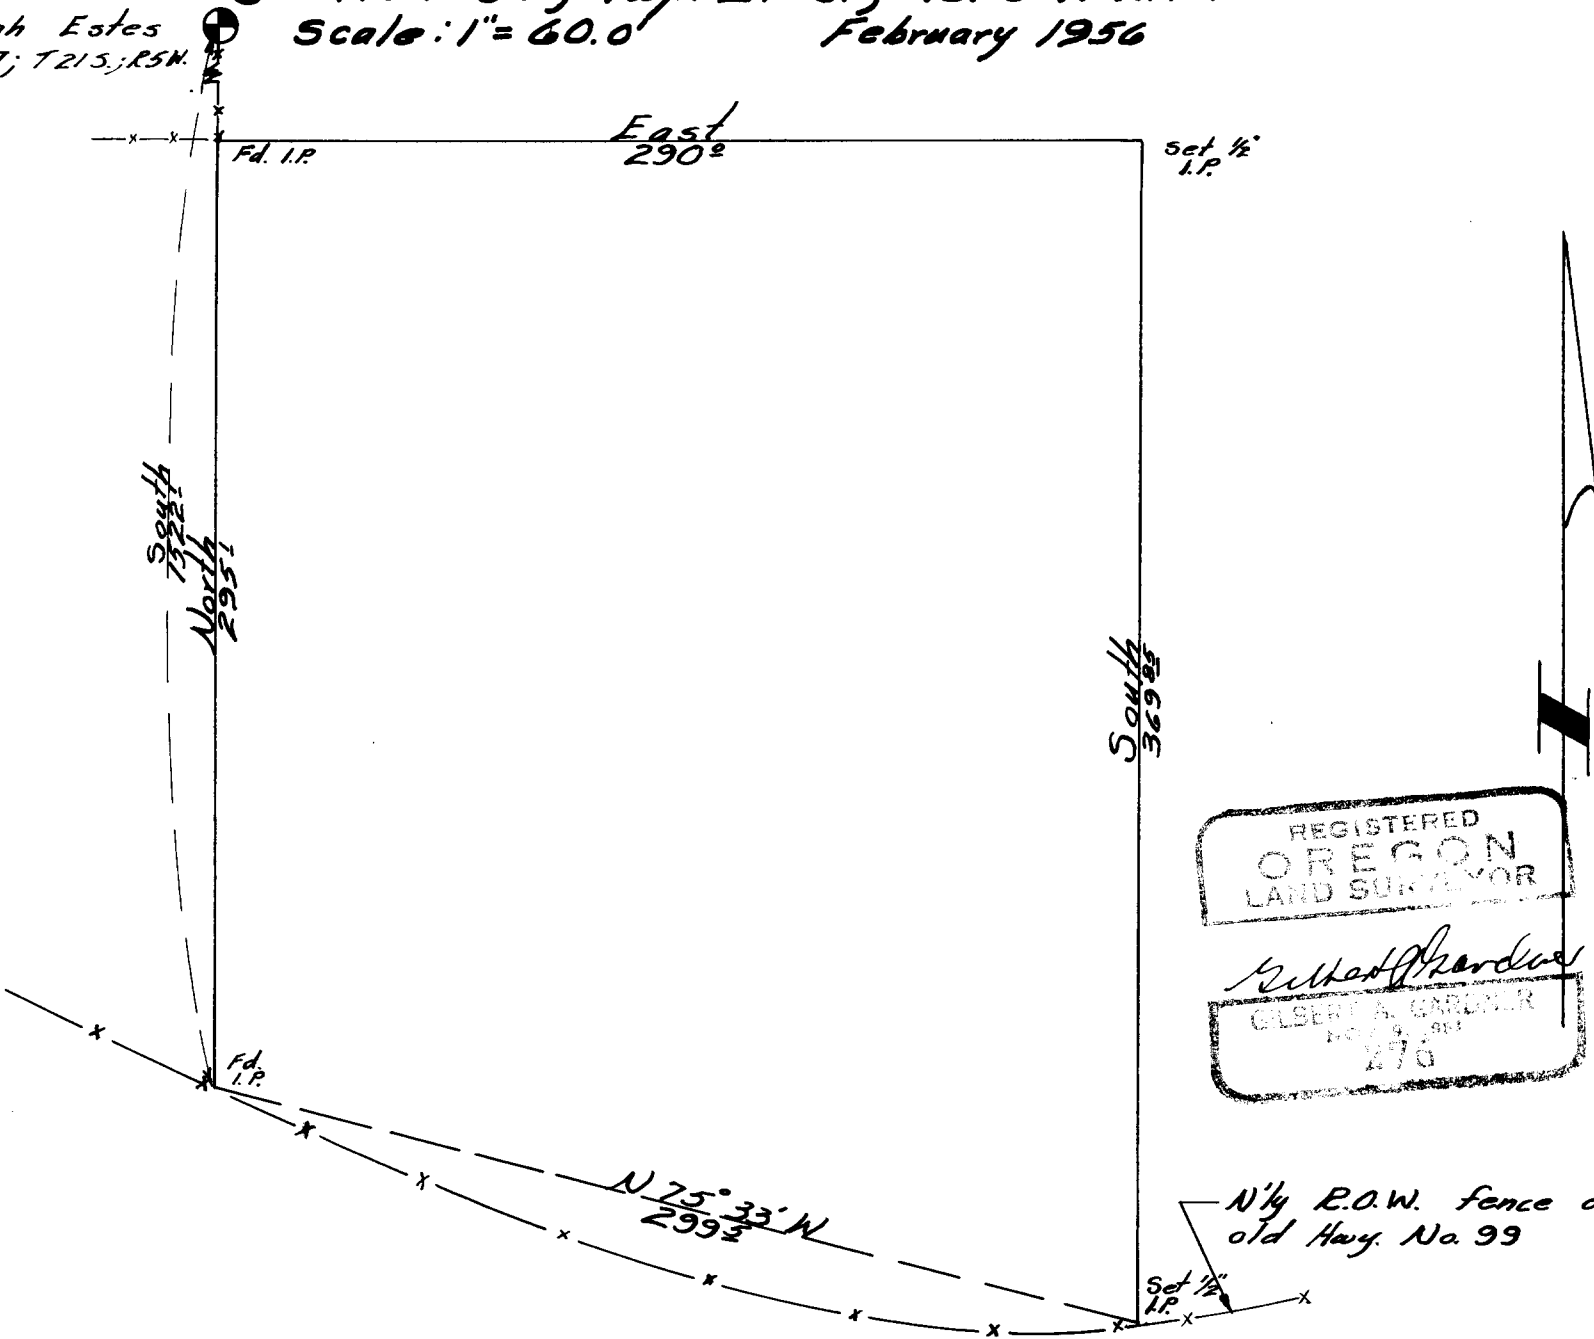

COUNTY SURVEYOR
DOUGLAS COUNTY, OR.

REGISTERED
OREGON
LAND SURVEYOR

Gilbert A. Gardner

GILBERT A. GARDNER
No. 9, 1st
270

N¹/₄ E.O.W. fence of
old Hwy. No. 99

FILED
RECEIVED
FEB 23 1956
COUNTY SURVEYORS FILE DATA
DO NOT REMOVE FROM OFFICE

C. S. File No. 42/127