

T30S RAW SEC 30

RENEWAL OF $\frac{1}{4}$ COR. $\frac{30}{31}$

● (AN IRON PIPE HERE DOES NOT CHECK WITH O.B.T.'S)

I FIND ORIGINAL CORNER STONE STILL
IN PLACE AND 1 ORIGINAL B.T., 17" D. FIR,
N 71° E, 25.0 FT. IN GOOD CONDITION.

OTHER O.B.T. A ROTTED STUMP.

I SCRIBE NEW B.T. AS FOLLOWS:


16" D. FIR, S 12° E, 20.5 FT.

R. M. Thompson, R. ENG.

WIT.: WM. CHANDLER

FRED HOLSCHAW

APR. 15, 1956

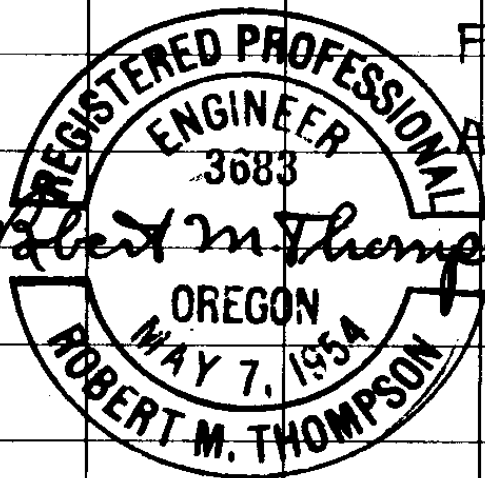

DIETZGEN NO. 386-B

C. S. File No.

42/152

FOR B + M LOGGING Co.