

DOUGLAS COUNTY FOREST APPRAISAL DEPARTMENT
 REPORT OF SURVEY CORNERS FOUND

Date June 6, 1956


Tp. 22 S. Rge. 9 W., W.M.

Corner Found NE 1/4 D.L.C. # 41

Photo Location _____

Evidence of Corner 2 B.T.s and stake

Corner Location in Reference
 to Terrain and Cover on the East
Edge of a High Flat Ridge

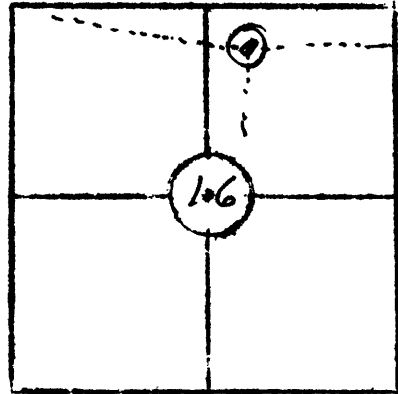

BEARING TREES FOUND

Quadrant	NE	NW	SW	SE
Dist. & Brg. From Corner		N 50 W	S 08° E	
Species & Size		44" D. Fir (dead)	40" D. Fir	
Condition of Scribe or Scar		bark scribe	stump good scribe	
Original or Resurvey BT Appearance of BT		orig	orig	
Tags, Marks, Etc. on BT		Nailed a brass cap to tree	Nailed Brass cap	

OTHER INFORMATION _____

MARKS OR TAGS LEFT AT CORNER OR NEARBY None except I Nailed a brass cap to each B.T. - inscribed survey point - Wilford N. Haines # 239

DESCRIPTION OF LINES LEADING TO CORNER There is a blazed line N 86° W and one blazed East

HOW CAN CORNER BE BEST REACHED: _____

REMARKS: drove a 3/8 angle iron with Brass cap inscribed survey point - Wilford N. Haines # 239

NAME Wilford N. Haines